

KANSAS

Rice

Section 16 Township 20 Range 9W

Well No. #3 McGlynn "B"


Company Cities Service

Chase Pool

NORTH

WEST

EAST

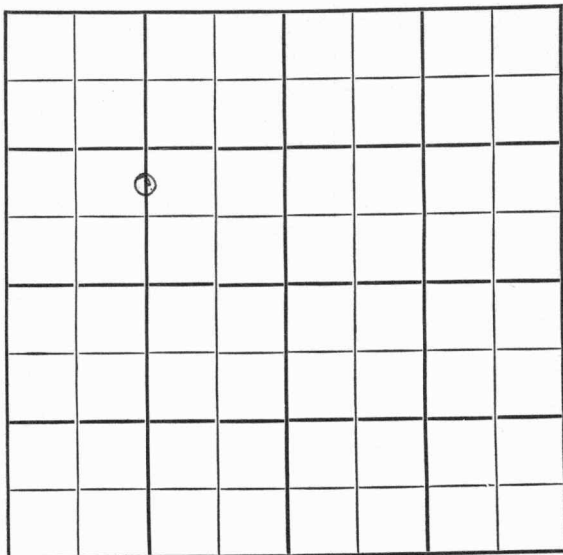

SOUTH

KANSAS

Rice

Sec. 16 Twp. 20 R. 9W

Well No. #3 McGlynn "B" Farm

Cities Service Company

Chase Pool


Ft. from N. Line

990' Ft. from S. Line

1320' Ft. from E. Line

Ft. from W. Line

C N L S $\frac{1}{2}$ NW

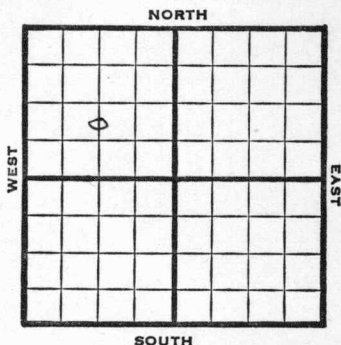

1948

Elev. 1727' REPORT

2/11 Location

2/18 RUR

2/25 8" @ 239'
Drlg. 2235'

3/3 "

3/10 Lansing 2920'
Arbuckle 3249-51'
3251' TD
4 $\frac{1}{2}$ " @ 3250'
RUST

3/17 SIM 3251 equals 3247'
Arbuckle 3245'
4 $\frac{1}{2}$ " @ 3246'
TD 3248'
Swab 28 bbls. oil / 96 W in 24 hrs.

3/24 Swb 35 bbls oil & 75 W in 24 hrs.

3/31 Arbuckle 3245'
4 $\frac{1}{2}$ " @ 3246'
Pump 30 oil / 100 W Pot
Gr. 42°
TD 3248'

COMPLETED

Map No. _____ Sec. 16 Twp. 20 R. 9W


Well No. 3 McGlynn "B"

Cities Service Company

FIRST REPORT Contractor

C N L S $\frac{1}{2}$ NW

SECTION PLAT

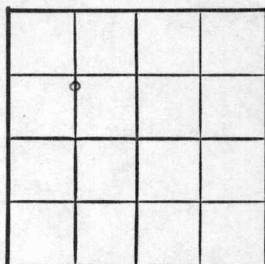

_____ Ft. from N. Line

990 Ft. from S. Line

1320 Ft. from E. Line

_____ Ft. from W. Line

Rice County

Location X

Rig up _____

Drilling and Remarks:

RECORD

Cased _____ in., _____ ft.

Sand _____

Gas _____

Oil _____

Total Depth _____

PRODUCTION

1st 24 hrs. Nat. _____

1st 24 hrs. after shot _____

Gas _____ Cu. Ft.

Dry Hole _____

Abandoned _____

Date

FEB 11 1948 19

S. J. LEWIS Scout

Map No. 49 Sec. 16 Twp. 20 R. 9W

Well No. 3 McGlynn "B"

Cities Service


Company

COMPLETE

Contractor

C N L S $\frac{1}{2}$ NW

E 1/2
SECTION PLAT

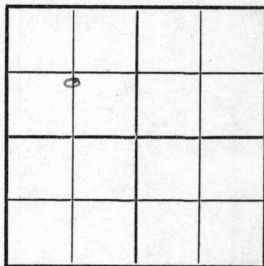

 Ft. from N. Line

990 Ft. from S. Line

1320 Ft. from E. Line

 Ft. from W. Line

Rice County

Location

Rig up

Drilling and Remarks:

Cor 3245

4 1/2" @ 3246

Pump 30 oil 7100

W B D

42 3/4

RECORD

Cased in., ft.

Sand

Gas

Oil

Total Depth 3245

PRODUCTION

1st 24 hrs. Nat.

1st 24 hrs. after shot

Gas Cu. Ft.

Dry Hole

Abandoned

Date

MAR 31 1948

19

S. J. LEWIS

Scout