
FORM 51

Barton KANSAS

Section 15 Township 20 Range 12 W

Well No. # 3 Buckbee

Company Lewis Drlg.

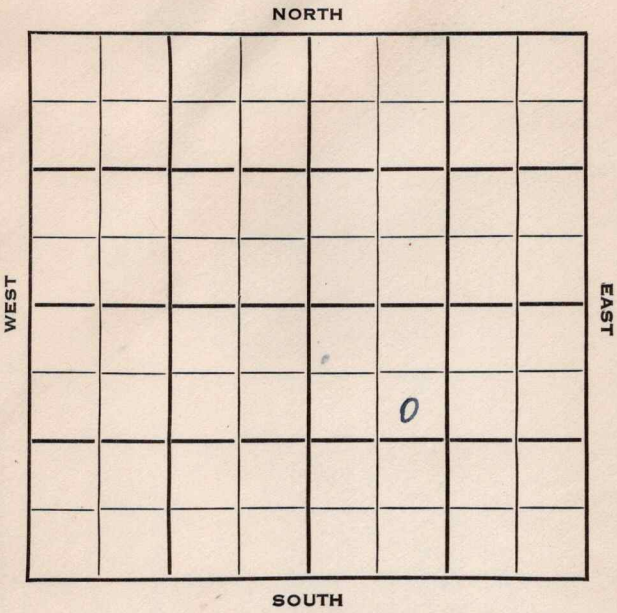

FORM 252-B

Barton KANSAS

Sec. 15 Twp. 20 R. 12 W

Well No. # 3 Buckbee Farm

Lewis Drlg. Company

Lewis Drlg. Contractor

Buckbee Pool


990 Ft. from N. Line

Ft. from S. Line

Ft. from E. Line

990 Ft. from W. Line

SE NW SE

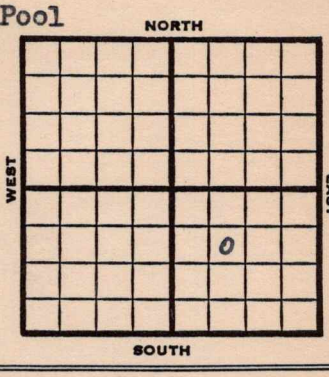

1953	REPORT Elev. 1812'
8/26	Spud 8-17-53 8" @ 180 Heeb 2999' Br lime 3120' Lans 3138' Cong. 3366 Arb. 3372 DST 3375-80 open 1 hr rec 4' mud DST 3381-86 open 1 hr rec 10' mud TD 3386 5" @ 3386
9/16	Spud 8-17-53 Oil Well TD 3386 8" @ 180 Heeb 2999, Br Lime 3120, Lans 3138, Cong 3366, Arb. 3372, DST 3375-80, opn 1 hr., rec. 4' mud DST 3381-86, opn 1 hr., rec. 10' mud TD 3386 5" @ 3386 DD 3388, 100A B/1 boph 500A S /2½ boph St-frac Comp. 103 bopd

COMPLETED

FORM 275 FOR SALE BY KANSAS BLUE PRINT CO.


County Barton State Kansas

Sec. 15 (Blk. Twp.) 20 (Sur. Rge.) 12W Map No.

Operator Lewis Drlg.

Well No. 3 Farm Buckbee

Elev. 1812 Location SE NW SE

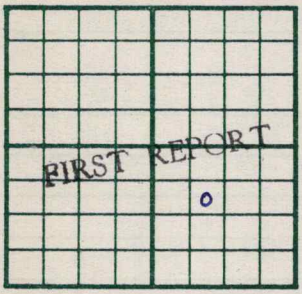

990 Ft. From N Line SE

990 Ft. From W Line Quarter

1st. Report AUG 26 1953

Completion

Remarks

Lewis Drlg. - Contr.

Spudding Date 8-17-53

Drlg. Data Buckbee Pool

8" @ 180 Heeb. 2999 Br. lime 3120

Lans. 3138 Cong. 3366 Arb. 3372

DST 3375-80 open 1 hr. Rec. 4' mud

DST 3381-86 open 1 hr. Rec. 10' mud

TD 3386 5" @ 3386

J. G. McGEHEE

FORM 275 FOR SALE BY KANSAS BLUE PRINT CO.

County Barton State Kansas

Sec. 15 (Blk. Twp.) 20 (Sur. Rge.) 12W Map No.

Operator Lewis Drlg.

Well No. 3 Farm Buckbee

Elev. 1812 Location SE NW SE



990 Ft. From N Line SE

990 Ft. From W Line Quarter

1st. Report

Completion SEP 16 1953

Remarks Buckbee Pool

Lewis Drlg. - Contr.

Spudding Date 8-17-53

Drlg. Data Oil well TD 3386

8" @ 180 Heeb. 2999 Br. lime 3120

Lans. 3138 Cong. 3366 Arb. 3372

DST 3375-80 open 1 hr. Rec. 4' mud

DST 3381-86 open 1 hr. Rec. 10' mud

TD 3386 5" @ 3386 DD 3388 100 A

B/ 1 boph 500 A S/ 2½ boph st-frac

Comp. 103 bopd

J. G. McGEHEE