


*Summer*

Map No. *171NS* Sec. *25* Twp. *31* R. *2E*  
 Well No. *1* *Herrick* Farm  
*Wentz Oil* Company  
 NORTH

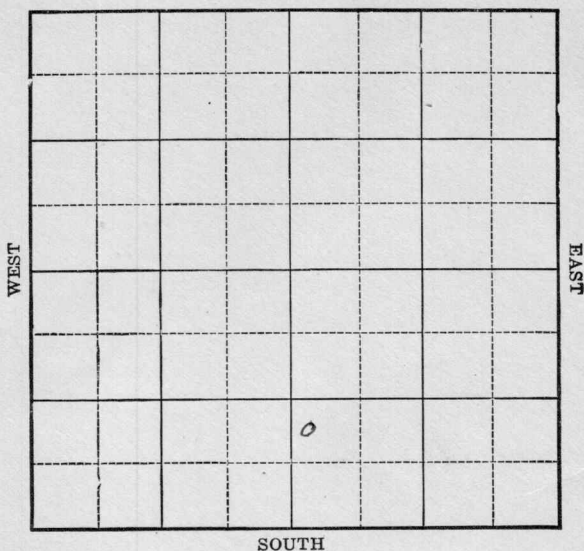

Location \_\_\_\_\_  
 Drilling Remarks \_\_\_\_\_

Rig Up \_\_\_\_\_  
 Drilling Remarks \_\_\_\_\_

**RECORD**

Cased \_\_\_\_\_ in. \_\_\_\_\_ ft.  
 Sand \_\_\_\_\_  
 Gas \_\_\_\_\_  
 Oil \_\_\_\_\_  
 Total Depth \_\_\_\_\_

**PRODUCTION**

1st 24 hrs. Nat. \_\_\_\_\_  
 1st 24 hrs. after shot \_\_\_\_\_  
 Gas \_\_\_\_\_ cu. ft.  
 Dry Hole \_\_\_\_\_  
 Abandoned \_\_\_\_\_

Map No. Kansas Sec. 25 Twp. 31 R. 2<sup>E</sup>Well No. 1 Herrick FarmWentz Oil Company

Ft. from N. Line

1100

Ft. from S. Line

990

Ft. from E. Line

220

Ft. from W. Line

300

NORTH

WEST

EAST

SOUTH

Date

REPORT

19266/30 Location7/14 Same7/22 —7/28 —8/4 —8/11 —8/18 —8/25 rig9/1 Spud9/8 Drilg 4559/15 fsg 8759/22 Drilg 15609/29 " 174410/6 No report High water10/13 T.S. 1838 - J.R. 1893swabbed 305 bblsshot 60 / 1205 bbls

K1 KANSAS  
 Map No. \_\_\_\_\_ Sec. 25 Twp. 31 R. 2E

Well No. 1 Herrick

Hertz Oil Company

Contractor

## SECTION PLAT

\_\_\_\_\_ Ft. from N. Line

990 Ft. from S. Line

\_\_\_\_\_ Ft. from E. Line

300 Ft. from W. Line

|  |  |   |  |
|--|--|---|--|
|  |  |   |  |
|  |  |   |  |
|  |  |   |  |
|  |  | 0 |  |

## FIRST REPORTS

Location \_\_\_\_\_

Rig up \_\_\_\_\_

Drilling and Remarks:

Location

## RECORD

Cased \_\_\_\_\_ in., \_\_\_\_\_ ft.

Sand \_\_\_\_\_

Gas \_\_\_\_\_

Oil \_\_\_\_\_

Total Depth \_\_\_\_\_

## PRODUCTION

1st 24 hrs. Nat. \_\_\_\_\_

1st 24 hrs. after shot \_\_\_\_\_

Gas \_\_\_\_\_ Cu. Ft.

Dry Hole \_\_\_\_\_

Abandoned \_\_\_\_\_

Date

JUN 30 1926

192


S. J. LEWIS

Scout

Map No. KANSAS Sec. 25 Twp. 31 R. 2EWell No. 1 HarriekWentz Oil Company

Contractor

## SECTION PLAT

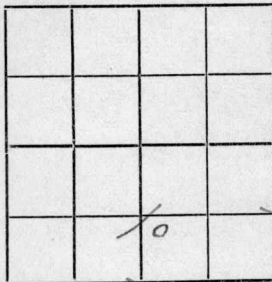

Ft. from N. Line

1100 Ft. from S. Line

Ft. from E. Line

220 Ft. from W. LineCorrection

Location

Rig up

Drilling and Remarks:

Rig  
I reported this  
990 from S. L.  
x 300 from W. L.  
should be  
1100 x 220.

## RECORD

Cased \_\_\_\_\_ in., \_\_\_\_\_ ft.

Sand \_\_\_\_\_

Gas \_\_\_\_\_

Oil \_\_\_\_\_

Total Depth \_\_\_\_\_

## PRODUCTION

1st 24 hrs. Nat. \_\_\_\_\_

1st 24 hrs. after shot \_\_\_\_\_

Gas \_\_\_\_\_ Cu. Ft.

Dry Hole \_\_\_\_\_

Abandoned \_\_\_\_\_

Date

AUG 25 1926192S. J. LEWISScout

Map No. KANSAS Sec. 25 Twp. 31 R. 2E

Well No. 1 Herriks

Shantz Oil Company  
Contractor

SECTION PLAT


----- Ft. from N. Line

1100 Ft. from S. Line

----- Ft. from E. Line

220 Ft. from W. Line

COMPLETED

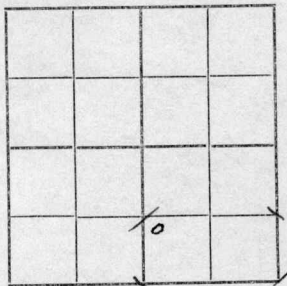

Location -----

Rig up -----

Drilling and Remarks:

*7/8 1838.*

*7/11/893*

*Swabbed 305 ft.*

*Shut 60 gts.*

*1205 ft.*

RECORD

Cased ----- in., ----- ft.

Sand -----

Gas -----

Oil -----

Total Depth -----

PRODUCTION

1st 24 hrs. Nat. -----

1st 24 hrs. after shot. -----

Gas ----- Cu. Ft.

Dry Hole -----

Abandoned -----

Date

OCT 13 1926

192

S. J. LEWIS

Scout