


Summit

Map No. KANSAS Sec. 25 Twp. 31 R. 2^E

Well No. 2-*Herrick* Farm
W. R. Mann Coal Company

NORTH

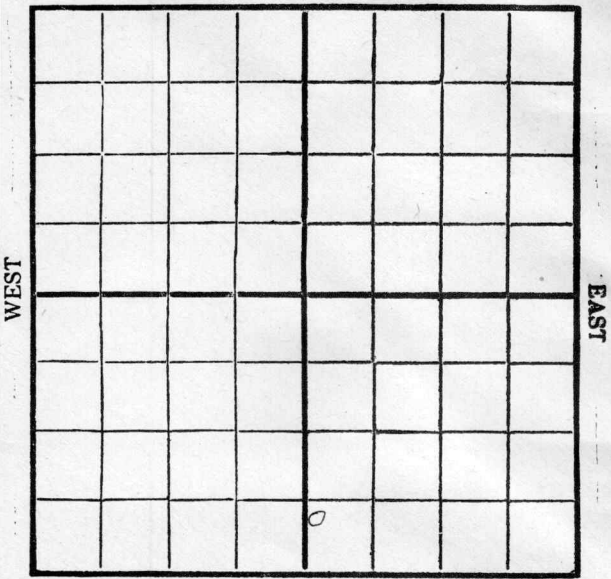

SOUTH

Location _____

Drilling Remarks _____

Rig Up _____

Drilling Remarks _____

RECORD

Cased _____ in. _____ ft.

Sand _____

Gas _____

Oil _____

Total Depth _____

PRODUCTION

1st 24 hrs. Nat. _____

1st 24 hrs. after shot _____


Gas _____ cu. ft. _____

Dry Hole _____

Abandoned _____

Map No. KANSAS Sec. 25 Twp. 31 R. 2^E
 Well No. 2- Kurruck Farm
W. K. Mannelkal Company

NORTH

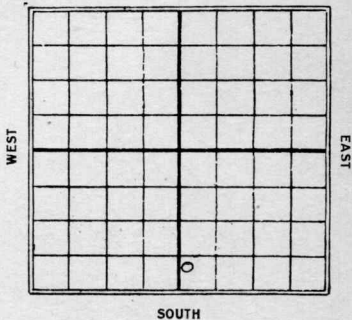

_____ Ft. from N. Line

540 Ft. from S. Line

_____ Ft. from E. Line

55 Ft. from W. Line

1930

Date	REPORT
10/29	Run up
11/5	Spdy
11/12	" " 180'
11/19	WRLy 420'
11/26	" " 485
12/3	" " 1075
12/10	HEW 1412
	WRLy 1565
12/17	Top sand 1851
	Perly 5"
12/23	T.D. 1900' Testing
12/30	—
1931	—
1/7	Sand 1854-99
	shot 15 qt 1879-99
	T.D. 1899
	10 bbl. oil
	Comp.

Summer

1 **KANSAS** Sec. *25* Twp. *31* R. *2* ^E

Well No. *2* *Herrick*

W. K. Mann et al Company

Contractor

FIRST REPORTS

SECTION PLAT

..... Ft. from N. Line

540 Ft. from S. Line

..... Ft. from E. Line

55 Ft. from W. Line

Location.....

Rig up.....

Drilling and Remarks:

Rigging up.

RECORD

Cased..... in., ft.

Sand.....

Gas.....

Oil.....

Total Depth.....

PRODUCTION

1st 24 hrs. Nat.....

1st 24 hrs. after shot.....

Gas..... Cu. Ft.

Dry Hole.....

Abandoned.....

Date

OCT 29 1930

CHAS. L. SHERWOOD
192 Scout

Summer

Map No. KANSAS Sec. 25 Twp. 31 R. 2 ^E

Well No. 2 Herick

W.K. Mann et al Company

Contractor

COMPLETE

SECTION PLAT

..... Ft. from N. Line

540 Ft. from S. Line

..... Ft. from E. Line

55 Ft. from W. Line

		0	

Location.....

Rig up.....

Drilling and Remarks:

50/1879-1899

10 bbs.

RECORD

Cased..... in., ft.

Sand 1854-1899

Gas.....

Oil.....

Total Depth 1899

PRODUCTION

1st 24 hrs. Nat.....

1st 24 hrs. after shot.....

Gas..... Cu. Ft.

Dry Hole.....

Abandoned.....

Date

JAN 7 1931

192.....

CHAS. L. SHERWOOD

Scout