

KANSAS


Butler county



Section 6 Township 27 Range 8-E

Well No. #1, Lucas

Company E. H. Adair

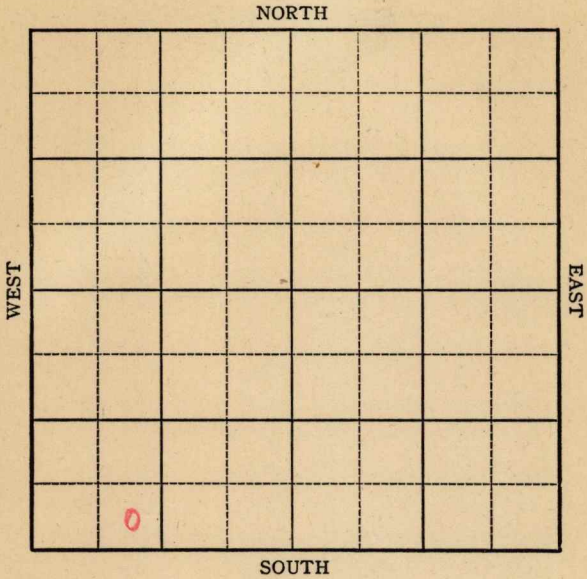

Sec. 6 Twp. 27 R. 8E

Well No. 1 Lucas Farm

E. H. Adair Company

Miscellaneous


 Ft. from N. Line

330 Ft. from S. Line

 Ft. from E. Line

910 Ft. from W. Line
of section

C S L LOT 27 SW

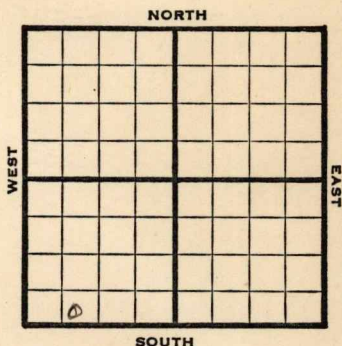

1946

REPORT

11/13	Drlg 450'
11/20	20" @ 18'
	15" @ 280'
	12" @ 805'
	Drlg 1305'
11/27	Drlg 1445'
12/3	ΔC 2060'
	Drlg 2550'
12/11	Bart 2670'
	6" @ 2670'
	TD 2765'
	120 qts 2735-2765'
	Pump 30 POT
	36 Grav.

COMPLETED

Map No. 10 Sec. 6 Twp. 27 R. 8E

Well No. 1 Lucas

E. H. Adair Company

FIRST REPORT Contractor

C S L Lot 27 SW

SECTION PLAT

 Ft. from N. Line

330 Ft. from S. Line

 Ft. from E. Line

910 Ft. from W. Line *7 sec.*

Butler County

Location

Rig up

Drilling and Remarks:

drlg. 450

RECORD

Cased in., ft.

Sand

Gas

Oil

Total Depth

PRODUCTION

1st 24 hrs. Nat.

1st 24 hrs. after shot

Gas Cu. Ft.

Dry Hole

Abandoned

Date

NOV 13 1946

19

S. J. LEWIS Scout

Kansas

Map No. _____ Sec. 6 Twp. 27 R. 8EWell No. 1 LucasE. H. Adair

Company

COMPLETED

Contractor

C S L Lot 27 SW

SECTION PLAT

_____ Ft. from N. Line

330 Ft. from S. Line

_____ Ft. from E. Line

910 Ft. from W. LineButler County

RECORD

Location _____

Cased _____ in., _____ ft.

Rig up _____

Sand _____

Drilling and Remarks:

Gas _____

Oil _____

Total Depth 2765

PRODUCTION

1st 24 hrs. Nat. _____

1st 24 hrs. after shot _____

Gas _____ Cu. Ft.

Dry Hole _____

Abandoned _____

Date

DEC 1 1 1946 19S. J. LEWIS

Scout