


Map No. 1000 Sec. 25 Twp. 31 R. 2 E
 Well No. 4 Herrick Farm
Wentz Oil Company

..... Ft. from N. Line
1100 Ft. from S. Line
 Ft. from E. Line
640 Ft. from W. Line

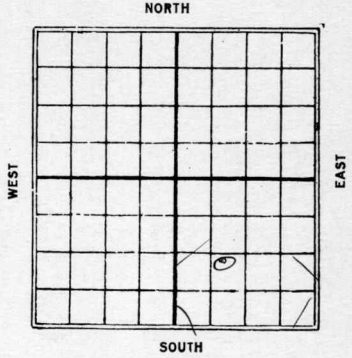

1926

Date	REPORT
10/13	Rigging up
10/20	Spud
10/27	S.D. 113 Spidrig
11/3	Spud 225'
11/10	Drly 875
11/17	" 1265
11/24	" 1390
12/1	" 1614
12/8	T.Sd. 1870' show oil 1884' to 1900' 1910' T.D. H.F.W. plugging back to 1908'
12/15	mud off sand 1870' to 1910' S.D.
12/21	same
12/29	_____
1927	
1/5	Rigging up to drill deeper
1/12	_____
1/19	Rigging up
1/26	Drly 1945
2/2	T.D. 1970-8"-froze
2/9	Drilling - 2200
2/16	" 2760

7/23 - T. D. 2800 H.F.W. - run 6"

3/2 - F.A. 2860 - HFW 2845
D. & A.

Map No. KANSAS Sec. 25 Twp. 31 R. 2E

Well No. 4 Herrick

Shoutz Oil Company

Contractor


SECTION PLAT

----- Ft. from N. Line

1100 Ft. from S. Line

----- Ft. from E. Line

640 Ft. from W. Line

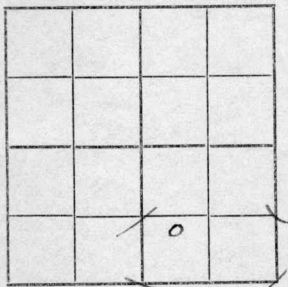

FIRST REPORTS

Location -----

Rig up -----

Drilling and Remarks:

Rigging up.

RECORD

Cased ----- in., ----- ft.

Sand -----

Gas -----

Oil -----

Total Depth -----

PRODUCTION

1st 24 hrs. Nat. -----

1st 24 hrs. after shot -----

Gas ----- Cu. Ft.

Dry Hole -----

Abandoned -----

Date -----

OCT 13 1926

S. J. LEWIS

Scout

Map No. KANSAS Sec. 25 Twp. 31 R. 2E7

Well No. 4 Herrick

Hertz Oil Company

Contractor

SECTION PLAT

----- Ft. from N. Line

1100 Ft. from S. Line

----- Ft. from E. Line

670 Ft. from W. Line

ABANDONED

Location -----

Rig up -----

Drilling and Remarks:

T. 2860

HFN 2845

J. A.

RECORD

Cased ----- in., ----- ft.

Sand -----

Gas -----

Oil -----

Total Depth -----

PRODUCTION

1st 24 hrs. Nat. -----

1st 24 hrs. after shot -----

Gas ----- Cu. Ft.

Dry Hole -----

Abandoned -----

Date

MAR 2 1927

192

S. J. LEWIS

Scout

Shimmer
K1 MAP NO. KANSAS SEC. 25 TWP. 315 R. 2E

WELL NO. L. H. Bentley

L. H. Bentley COMPANY

CONTRACTOR

SECTION PLAT

		0	

_____ FT. FROM N. LINE

_____ FT. FROM S. LINE

_____ FT. FROM E. LINE

_____ FT. FROM W. LINE

LOCATION _____

RIG UP _____

DRILLING AND REMARKS:

H. J. W.
on

RECORD

CASED _____ IN., _____ FT.

SAND _____

GAS _____

OIL _____

TOTAL DEPTH 7860

PRODUCTION

1ST 24 HRS. NAT. _____

1ST 24 HRS. AFTER SHOT _____

GAS _____ Cu. Ft.

DRY HOLE

ABANDONED

DATE

3/1

1927

SCOUT