


Section 6 Township 27 Range 8 E

Well No. # 2 Lucas

Company Franco Central Oil Co.

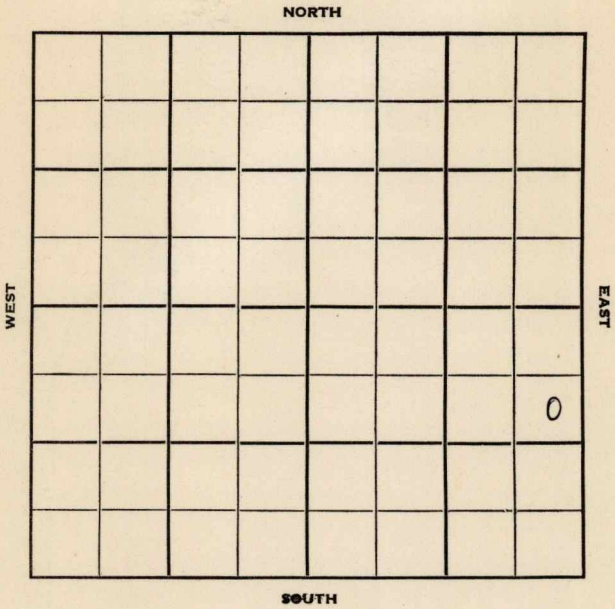

Butler

KANSAS

Sec. 6 Twp. 27 R. 8 E

Well No. # 2 Lucas Farm

France Central Oil Co. Company

Contractor


Ft. from N. Line

990 Ft. from S. Line

330 Ft. from E. Line

Ft. from W. Line

NE SE Lot 25

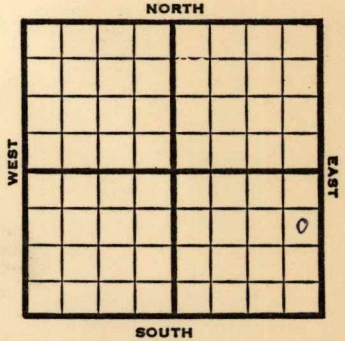

1951

Elev. ¹⁵¹¹ ~~1502~~⁺ REPORT

7/11

Spud 7-6-51
8" @ 100
Lans 1701' KC 2005'
Drlg. 2135'

8/1

Spud 7-6-51
Oil Well TD 2718
8" @ 100
Lans. 1701 KC 2005
Bart 2604 Sand 2669
TD 2718
5" @ 2692
S/4 goph Hydrafrac
Comp. 20 bopd

COMPLETED

County Butler State Kansas

Sec. 6 (Blk.) 27 (Sur.) 8E Map No.

Operator Franco Central Oil

Well No. 2 Farm Lucas

Elev. 1511 Location NE SE Lot 25

990 Ft. From S Line Lot 25

330 Ft. From E Line Quarter

1st. Report

Completion AUG 1 1951

Remarks

Spudding Date 7-6-51

COMPLETE

Drlg. Data Oil well TD 2718

8" @ 100 Lans. 1701 KC 2005

Bart. 2604 Sand 2669 TD 2718

5" @ 2692 S/ 4 goph Hydrofrac

Comp. 20 bopd