


*Rick
9W*

Map No. KANSAS Sec. 16 Twp. 20 R. _____

Well No. 35 Smith _____ Farm
Supply Oil _____ Company

NORTH

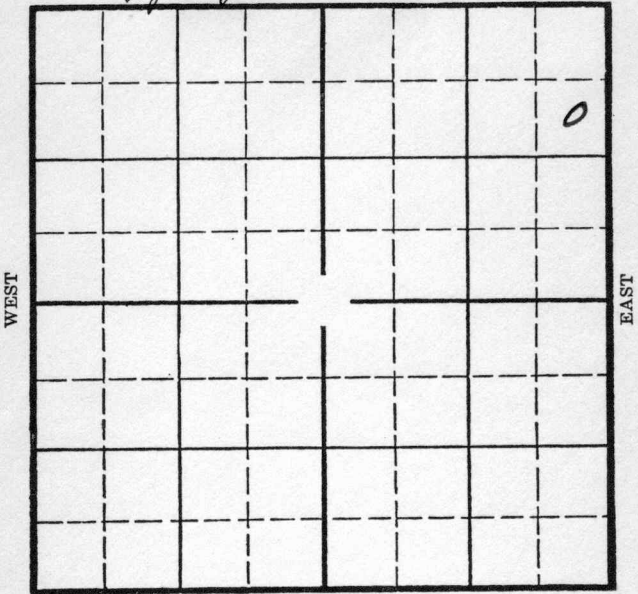

SOUTH

Location _____
Drilling Remarks _____

Rig Up _____
Drilling Remarks _____

RECORD

PRODUCTION

Cased _____ in. _____ ft.
Sand _____
Gas _____
Oil _____
Total Depth _____

1st 24 hrs. Nat. _____
1st 24 hrs. after shot _____
Gas _____ cu. ft. _____
Dry Hole _____
Abandoned _____

KANSAS

Rice

Map No. _____ Sec. 16 Twp. 20 R. 9W

Well No. 3- Smith Farm _____
Gypsy Oil Company _____


990 Ft. from N. Line

_____ Ft. from S. Line

330 Ft. from E. Line

_____ Ft. from W. Line

Elev. 1714

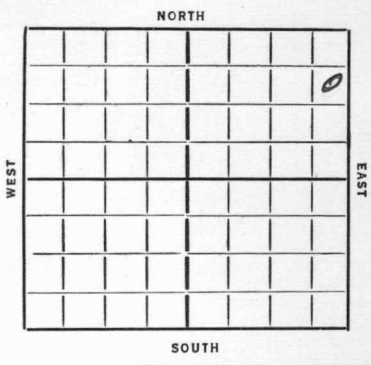

REPORT

Date	
1935	
10/2	Rgn
10/10	slg 2470
10/30	slt 3215
	TD 3239
	1350 Bbls.

COMPLETED

Map No. 49 Sec. 16 Twp. 20 R. 9W

Well No. 3-Smith

Superior oil Company

Contractor

COMPLETED

SECTION PLAT

			0

990 Ft. from N. Line

..... Ft. from S. Line

330 Ft. from E. Line

..... Ft. from W. Line

Location.....

Rig up.....

Drilling and Remarks:

1350 ft

RECORD

Cased..... in., ft.

Sand sil 3215

Gas.....

Oil.....

Total Depth 3239

PRODUCTION

1st 24 hrs. Nat.....

1st 24 hrs. after shot.....

Gas..... Cu. Ft.

Dry Hole.....

Abandoned.....

Date

10-30-35 192

ORVAL MANNSCHRECK

Scout

Map No. 49 Sec. 16 Twp. 20 R. 9W

Well No. 3-Smith

Supply oil Company

Contractor

FIRST REPORTS SECTION PLAT

990 Ft. from N. Line

..... Ft. from S. Line

330 Ft. from E. Line

..... Ft. from W. Line

			0

Location.....

Rig up.....

Drilling and Remarks:

Rigin

RECORD

Cased.....in.,ft.

Sand.....

Gas.....

Oil.....

Total Depth.....

PRODUCTION

1st 24 hrs. Nat.....

1st 24 hrs. after shot.....

Gas.....Cu. Ft.

Dry Hole.....

Abandoned.....

Date

10-7-35 192.....

ORVAL MANNSCHRECK

Scout