


Summer

Map No. *15* Sec. *25* Twp. *91* R. *2E*

Well No. *1 - Wrights Reitz* Farm
Derby Company

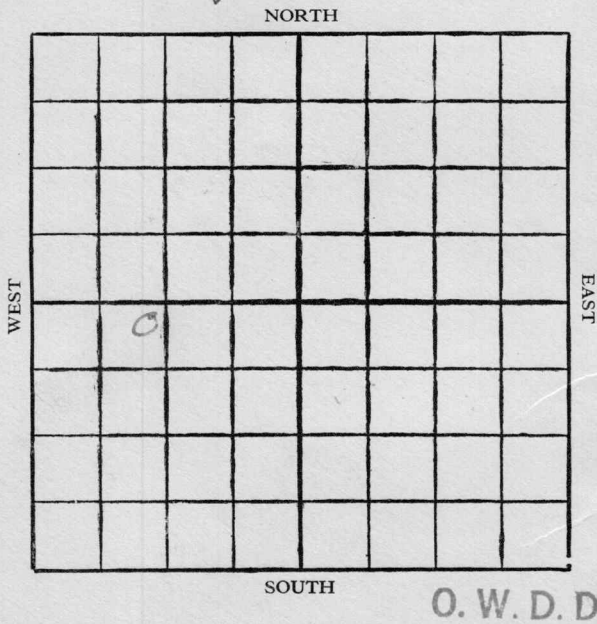

O. W. D. D

Location

Drilling Remarks

.....

.....

Rig Up

Drilling Remarks

.....

.....

RECORD

Cased in. ft.

Sand

Gas

Oil

Total Depth

PRODUCTION

1st 24 hrs. Nat.

1st 24 hrs. after shot

Gas cu. ft.

Dry Hole

Abandoned


Summer
 Map No. 15 Sec. 25 Twp. 31 R. 2E
 Well No. 1 - ~~straight~~ Reitz Farm
Serby Oil Company

218
~~517~~ Ft. from N. Line

_____ Ft. from S. Line

_____ Ft. from E. Line

1113
~~1112~~ Ft. from W. Line

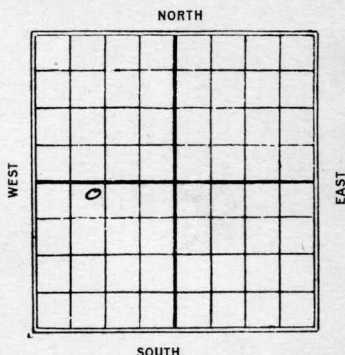

1927 2 1/2 acres

Date _____ REPORT O.W.D.D

1/5	Location
1/12	Rig
1/19	spud 155
1/26	Drlg 465
2/2	" 1109
2/9	" 1585
2/16	Top sand 1817 - oil 1841 T.D. 1893 Hole full oil - shot 100 gts 1840-91 - bridged - C.O.
2/22	T.S. 1817 - oil 1841 T.D. 1892 1/2 shot 100 gts 1840-1891 - swabbed 960 bbl in 24 hours
1935	O.W.D.D
10/30	P.B. 1613 Moving In.
11/7	11/14
11/21	slg 1870
11/29	Top 16 C 2159
12/6	slg 2535 Top sil 2660 TD 2680 40 6" 2663
12/13	Bailing

OVER

12/19 Water 2705-07 1/2
PB 2702 Shot 60 gts
fry railer

12/26 4000 acid

12/36 PB to KC lime

1/10 PB 2335

1/15 Sil 2660

TD 2707

PB 2702

PB 2335

60 gts

4000 acid

798 Blr.

COMPLETED

Map No. KANSAS Sec. 25 Twp. 31 R. 2E

Well No. 1 Wrights

Herby Oil Company

Contractor

SECTION PLAT

0			

219 Ft. from N. Line

_____ Ft. from S. Line

_____ Ft. from E. Line

1112 Ft. from W. Line

FIRST REPORTS

Location ✓

Rig up _____

Drilling and Remarks:

This acreage of Herby is about 1100 ft long by 90 ft wide 2 1/2 acres.

RECORD

Cased _____ in., _____ ft.

Sand _____

Gas _____

Oil _____

Total Depth _____

PRODUCTION

1st 24 hrs. Nat. _____

1st 24 hrs. after shot _____

Gas _____ Cu. Ft.

Dry Hole _____

Abandoned _____

Date

JAN 5 1927

S. J. LEWIS

Scout

Samuel
 Map No. KANSAS Sec. 25 Twp. 31 R. 24

Well No. 1 Ritz

Deery Oil Company

Contractor

SECTION PLAT

219 Ft. from N. Line

_____ Ft. from S. Line

_____ Ft. from E. Line

1112 Ft. from W. Line

o			

Correction

Location _____

Rig up _____

Drilling and Remarks:

*Reported this
 as Wright farm.
 should be
 Ritz*

RECORD

Cased _____ in., _____ ft.

Sand _____

Gas _____

Oil _____

Total Depth _____

PRODUCTION

1st 24 hrs. Nat. _____

1st 24 hrs. after shot _____

Gas _____ Cu. Ft.

Dry Hole _____

Abandoned _____

Date

JAN 19 1927

192

S. J. LEWIS

Scout

Sumner
KANSAS
 Map No. _____ Sec. *25* Twp. *21* R. *2E*

Well No. *1 Reitz*

Derby Oil Company

Contractor

SECTION PLAT

219 Ft. from N. Line

_____ Ft. from S. Line

_____ Ft. from E. Line

1112 Ft. from W. Line

0			

Correction

Location _____

Rig up _____

Drilling and Remarks:

*Report that
 as the Wrights
 farm should
 be Reitz*

RECORD

Cased _____ in., _____ ft.

Sand _____

Gas _____

Oil _____

Total Depth _____

PRODUCTION

1st 24 hrs. Nat. _____

1st 24 hrs. after shot _____

Gas _____ Cu. Ft.

Dry Hole _____

Abandoned _____

Date

JAN 26 1927

192

S. J. LEWIS

Scout

Map No. _____ Sec. 25 Twp. 31 R. 2E

Well No. 1- Reitz

Herby oil

Company _____

Contractor _____

FIRST REPORTS

SECTION PLAT


218 Ft. from N. Line

_____ Ft. from S. Line

_____ Ft. from E. Line

1113 Ft. from W. Line

Quidd

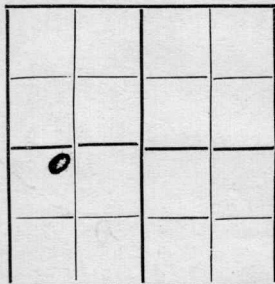

Location _____

Rig up _____

Drilling and Remarks:

OTD 1890

P.B. 1613

Moving in

RECORD

Cased _____ in., _____ ft.

Sand _____

Gas _____

Oil _____

Total Depth _____

PRODUCTION

1st 24 hrs. Nat. _____

1st 24 hrs. after shot _____

Gas _____ Cu. Ft.

Dry Hole _____

Abandoned _____

Date

10-30-35

192

ORVAL MANNSCHRECK

Scout

Map No. _____ Sec. 25 Twp. 31 R. 2EWell No. 1- ReitzDerby oil Company

Contractor

COMPLETE

SECTION PLAT

218 Ft. from N. Line

_____ Ft. from S. Line

_____ Ft. from E. Line

1113 Ft. from W. Line

0			

Location _____

Rig up _____

Drilling and Remarks:

P. B. 2702
 P. B. 2335
 60 gts.
 4000 and
 798 bbls

RECORD

Cased _____ in., _____ ft.

Sand Sil 2660

Gas _____

Oil _____

Total Depth 2707

PRODUCTION

1st 24 hrs. Nat. _____

1st 24 hrs. after shot _____

Gas _____ Cu. Ft.

Dry Hole _____

Abandoned _____

Date

ORVAL MANNSCHRECK

1-15-36 192 _____ Scout