


Summer

Map No. _____ Sec. *25* Twp. *31* R. *2 E*

Well No. *2 - Beitz* Farm _____
Derby oil Co. Company _____

NORTH

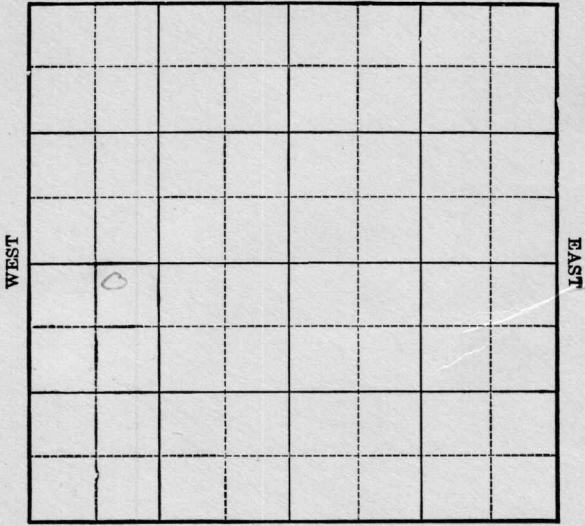

SOUTH

O. W. D. D

Location _____

Drilling Remarks _____

Rig Up _____

Drilling Remarks _____

RECORD

Cased _____ in. _____ ft.

Sand _____

Gas _____

Oil _____

Total Depth _____

PRODUCTION

1st 24 hrs. Nat. _____

1st 24 hrs. after shot _____

Gas _____ cu. ft.

Dry Hole _____

Abandoned _____

Summer

Map No. Sec. 25 Twp. 31 R. 2 E

Well No. 2 - Reitz Farm


Derby Oil Company

186 Ft. from N. Line

Ft. from S. Line

Ft. from E. Line

716 Ft. from W. Line

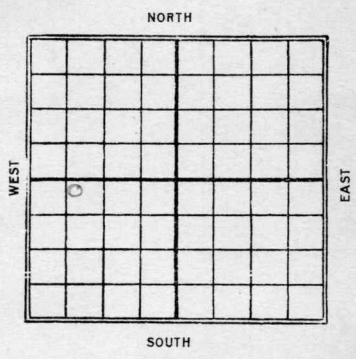

1927

Date	REPORT	O. W. D. D
------	--------	------------

3/2	Rig	
-----	-----	--

3/9		
-----	--	--

3/16	Rigging up	
------	------------	--

3/23	Spud	
------	------	--

3/30	T.D. 1000 fishing bailer	
------	--------------------------	--

4/6	Drlg 1220	
-----	-----------	--

4/13	" 1630	
------	--------	--

4/20	top sand 1838 - Oil 1868 - T.D. 1885	
------	--------------------------------------	--

	S.D. for high water	
--	---------------------	--

4/27	\$ 1838 oil 1868	
------	------------------	--

	T.D. 1890	
--	-----------	--

	shot 100 qts	
--	--------------	--

	1861 - 1888	
--	-------------	--

	683 bbls 18 hrs	
--	-----------------	--

1936	716 @ 2191	O. W. D. D
------	------------	------------

1/22	Rung 5" 2191	
------	--------------	--

1/31	5" 2191 slg 2264 300' pipe	
------	----------------------------	--

2/7	TD 2277 1000 acid	
-----	-------------------	--

2/14	Shot 10 qts 2213-23 @	
------	-----------------------	--

2/19	TD 2277 D.A.	ABANDONED
------	--------------	-----------

Map No. KANSAS Sec. 25 Twp. 31 R. 2E

Well No. 2 Reitz

Herby Oil Company

Contractor

SECTION PLAT

186 Ft. from N. Line

----- Ft. from S. Line

----- Ft. from E. Line

7/6 Ft. from W. Line

o			

FIRST REPORTS

Location -----

Rig up -----

Drilling and Remarks:

Rig

RECORD

Cased ----- in., ----- ft.

Sand -----

Gas -----

Oil -----

Total Depth -----

PRODUCTION

1st 24 hrs. Nat. -----

1st 24 hrs. after shot -----

Gas ----- Cu. Ft.

Dry Hole -----

Abandoned -----

Date

MAR 2 1927

S. J. LEWIS

Scout

Map No. KANSAS Sec. 25 Twp. 31 R. 2E

Well No. 2 Ritz

Terry Oil Company
Contractor

SECTION PLAT

186 Ft. from N. Line

----- Ft. from S. Line

----- Ft. from E. Line

7/6 Ft. from W. Line

o			

COMPLETED

Location -----

Rig up -----

Drilling and Remarks:

*T.S. 1838
Dil 1868
T.W. 1890
Cased 100 gals.
1861 & 1888
6838 & 6188*

RECORD

Cased ----- in., ----- ft.
Sand -----
Gas -----
Oil -----
Total Depth -----

PRODUCTION

1st 24 hrs. Nat. -----
1st 24 hrs. after shot -----
Gas ----- Cu. Ft.
Dry Hole -----
Abandoned -----

Date

APR 27 1927

S. J. LEWIS

Scout

Map No. 1 Sec. 25 Twp. 31 R. 2E

Well No. 2 - Reitz

Derby Oil Company

Contractor

SECTION PLAT

186 Ft. from N. Line

..... Ft. from S. Line

..... Ft. from E. Line

716 Ft. from W. Line

FIRST REPORT

OWDD

Location.....

Rig up.....

Drilling and Remarks:

OTD 1889

TKC 2191

Rng 5" - 2191

RECORD

Cased.....in.,ft.

Sand.....

Gas.....

Oil.....

Total Depth.....

PRODUCTION

1st 24 hrs. Nat.....

1st 24 hrs. after shot.....

Gas.....Cu. Ft.

Dry Hole.....

Abandoned.....

Date

JAN 22 1936 192

ORVAL MANNSCHHECK
Scout

Map No. _____ Sec. 25 Twp. 31 R. 2E

Well No. 2- Reitz

Herby Oil

Company

Contractor

ABANDONED

SECTION PLAT

186 Ft. from N. Line

_____ Ft. from S. Line

_____ Ft. from E. Line

716 Ft. from W. Line

o			

OWD

Location _____

Rig up _____

Drilling and Remarks:

N + A

RECORD

Cased _____ in., _____ ft.

Sand _____

Gas _____

Oil _____

Total Depth 2277

PRODUCTION

1st 24 hrs. Nat. _____

1st 24 hrs. after shot _____

Gas _____ Cu. Ft.

Dry Hole _____

Abandoned _____

Date

2-19-36 192

ORVAL MANNSCHRECK

Scout