


Map No. _____ Sec. 25 Twp. 31 R. 2E

Well No. 3 - Peitz Farm _____
Derby Oil Company _____

NORTH

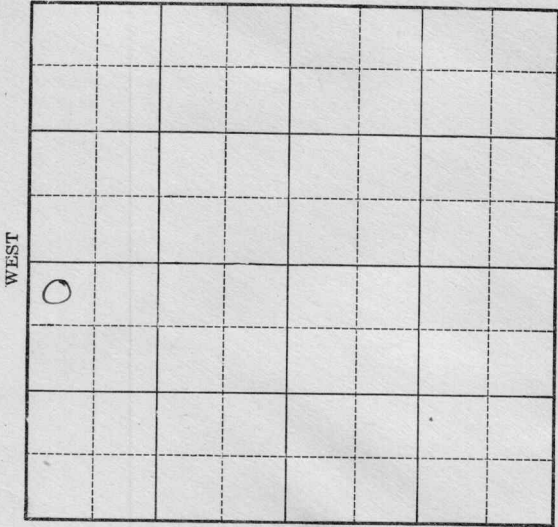

SOUTH

O. W. D. D

Location _____

Drilling Remarks _____

Rig Up _____

Drilling Remarks _____

RECORD

Cased _____ in. _____ ft.

Sand _____

Gas _____

Oil _____

Total Depth _____

PRODUCTION

1st 24 hrs. Nat. _____

1st 24 hrs. after shot _____

Gas _____ cu. ft.

Dry Hole _____

Abandoned _____

Map No. _____ Sec. 25 Twp. 31 R. 2E


Well No. 3 - Reitz Farm _____
Derby Oil Company _____

200 Ft. from N. Line

_____ Ft. from S. Line

_____ Ft. from E. Line

307 Ft. from W. Line

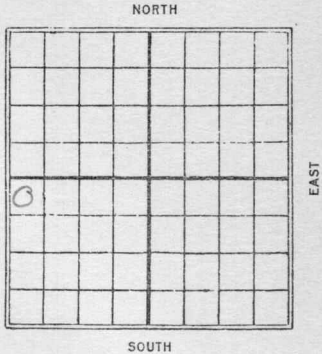

1927

Date	REPORT O. W. D. D
7/20	Machine-rigging up
7/27	Spud
8/3	Spud 135
8/10	Spud 280
8/17	Drilg 350'
8/24	T.D. 350 - S.D. high water
8/31	Drilg 595
9/7	" 1110
9/14	" 1502
9/20	" 1615
9/28	Top sand 1851 - T.D. 1908 - 33 bbls 3hrs. Natural
10/5	T.S. 1851 T.D. 1908 160 bbls nat. 24 hrs. 100/1872-1904 500 bbls 24 hrs
1936	O. W. D. D
1/29	7 1/2" 2203
	5" 2203
	7" 2207
2/7	10 gals 2220-30 CO 2245
2/14	1000 acid

OVER

2/19 TD 2245

D. A.

ABANDONED

Map No. KANSAS Sec. 25 Twp. 31 R. 2E

Well No. 3 Reitz

Derby Oil Company

Contractor

SECTION PLAT

200 Ft. from N. Line

_____ Ft. from S. Line

_____ Ft. from E. Line

307 Ft. from W. Line

0			

FIRST REPORTS

Location _____

Rig up _____

Drilling and Remarks:

Machine rigging up

RECORD

Cased _____ in., _____ ft.

Sand _____

Gas _____

Oil _____

Total Depth _____

PRODUCTION

1st 24 hrs. Nat. _____

1st 24 hrs. after shot _____

Gas _____ Cu. Ft.

Dry Hole _____

Abandoned _____

Date

JUL 20 1927

192

S. J. LEWIS

Scout

Map No. Summer Sec. 25 Twp. 31 R. 2 E

Well No. 3- Reitz

Herby oil

Company

Contractor

FIRST REPORTS

SECTION PLAT

200 Ft. from N. Line

..... Ft. from S. Line

..... Ft. from E. Line

307 Ft. from W. Line

Quodd

Location.....

Rig up.....

Drilling and Remarks:

OTN 1904 1/2
TKC 2203
5" 2203
TD 2207

RECORD

Cased..... in., ft.

Sand.....

Gas.....

Oil.....

Total Depth.....

PRODUCTION

1st 24 hrs. Nat.....

1st 24 hrs. after shot.....

Gas..... Cu. Ft.

Dry Hole.....

Abandoned.....

Date

1-29-36 192.....

ORVAL MANNSCHRECK

Scout

Map No. Sec. 25 Twp. 31 R. 2E

Well No. 3-Keitz

Herby Oil

Company

Contractor

ABANDONED

SECTION PLAT

0			

200 Ft. from N. Line

..... Ft. from S. Line

..... Ft. from E. Line

307 Ft. from W. Line

CW OD

Location

Rig up

Drilling and Remarks:

W & A

RECORD

Cased in., ft.

Sand

Gas

Oil

Total Depth 2245

PRODUCTION

1st 24 hrs. Nat.

1st 24 hrs. after shot

Gas Cu. Ft.

Dry Hole

Abandoned

Date

2-19-36 192

ORVAL MANNSCHRECK

Scout