KANSAS


Barton

FORM 51 5M 1-42 PETROL

Section 15 Township 20 Range 12-W

Well No. #1 Hulme

Company W. N. Bartlett

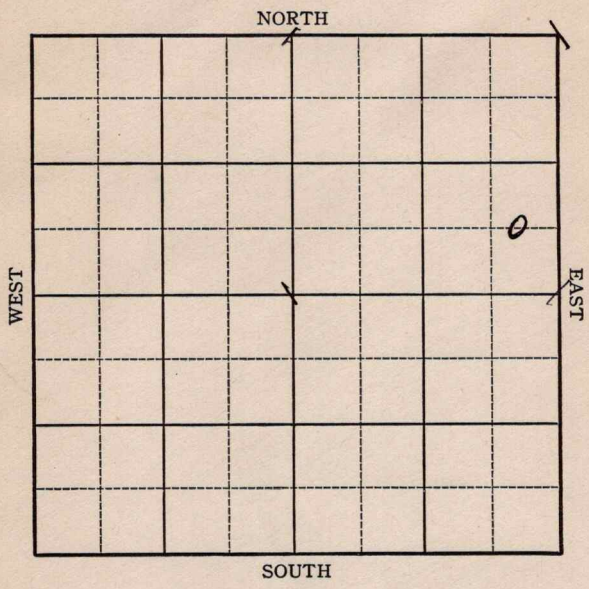

FORM 252-A
5M 9-42 GASS

KANSAS

Barton

Sec. 15 Twp. 20 R. 12-W

Well No. #1 Hulme Farm

W. N. Bartlett Company

Wildcat


____ Ft. from N. Line

660 Ft. from S. Line

330 Ft. from E. Line

____ Ft. from W. Line

Elev. 1814

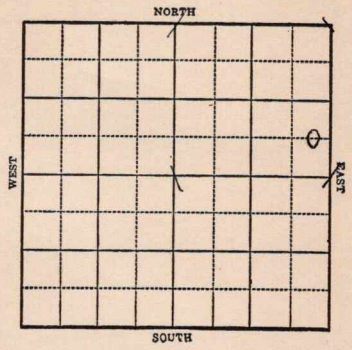

1943	REPORT
7/21	Location.
7/28	8" @ 285' Drlg. 1825'
8/4	Anhy 590 Topeka 2732 Drlg. 2946'
8/11	Lans 3144 Arb 3377 T.D. 3400'

ABANDONED

Form 26 200 Bks 5-42 Petrol Barton

KANSAS

Map No. 46 Sec. 15 Twp. 20 R. 12W

Well No. 1 Hulme

W. N. Bartlett Company

FIRST REPORT Contractor

C E L SE NE

Ft. from N. Line


660 Ft. from S. Line

330 Ft. from E. Line

Ft. from W. Line

WILDCAT

SECTION PLAT

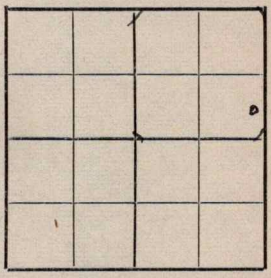

Location X

Rig up

Drilling and Remarks:

RECORD

Cased in., ft.

Sand

Gas

Oil

Total Depth

PRODUCTION

1st 24 hrs. Nat.

1st 24 hrs. after shot

Gas Cu. Ft.

Dry Hole

Abandoned

Date

JUL 21 1943 19 S. J. LEWIS Scout

Form 26 200 Bks 5-42 Petrol Barton

KANSAS

Map No. 46 Sec. 15 Twp. 20 R. 12W

Well No. 1 Hulme

W. N. Bartlett Company

ABANDONED

Contractor

C EL SE NE


Ft. from N. Line

660 Ft. from S. Line

330 Ft. from E. Line

Ft. from W. Line

SECTION PLAT

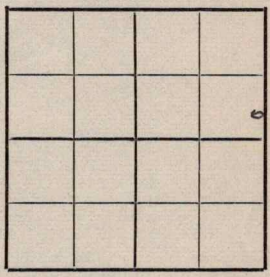

WILDCAT

Location

Rig up

Drilling and Remarks:

Lans 3144

Cir X 3377

RECORD

Cased in., ft.

Sand

Gas

Oil

Total Depth 3400

PRODUCTION

1st 24 hrs. Nat.

1st 24 hrs. after shot

Gas Cu. Ft.

Dry Hole

Abandoned

Date

AUG 1 1 1943 19

S. J. LEWIS Scout