


Map No. 7 Sec. 6 Twp. 27 R. 8

Well No. 3 Lucas Farm  
Brennan & Nixon, Limited Company

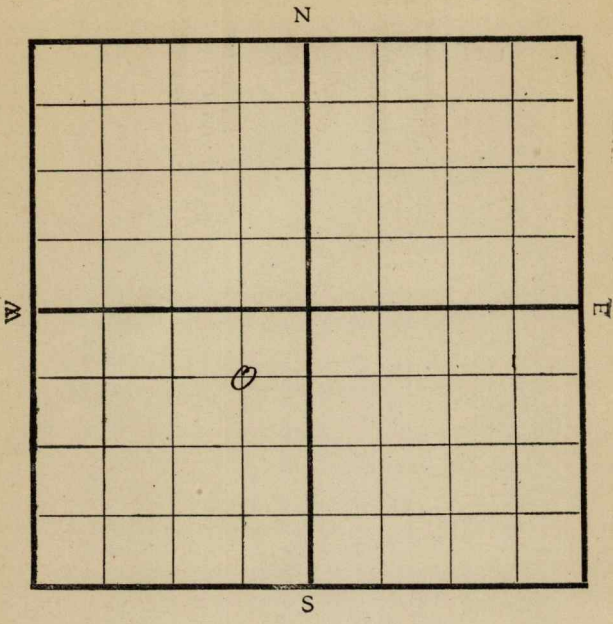

Location -----  
Drilling Remarks:

-----

-----

**RECORD**

Cased ----- in. ----- ft.

Sand -----

Gas -----

Oil -----

Total Depth -----

Rig Up -----  
Drilling Remarks:

-----

-----

**PRODUCTION**

1st 24 hrs. Nat. -----

1st 24 hrs. after shot -----

Gas ----- cu. ft.

Dry Hole -----


Abandoned -----

Map No. K Sec. 6 Twp. 27 R. 8

Well No. 3 Lucas Farm

Brennan & Newton Company

NORTH

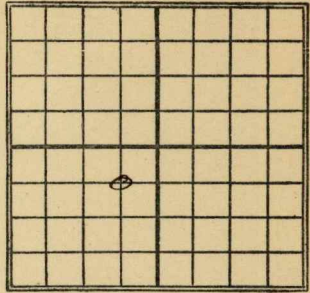

660 Ft. from N. Line

\_\_\_\_\_ Ft. from S. Line

660 Ft. from E. Line

\_\_\_\_\_ Ft. from W. Line

Date

REPORT

1/27  
3/30  
5/6

Reg. up  
S. D. 2600  
Sand 2712-24  
Dry & Abd 2727'

K10 *Kans*  
 Map No. \_\_\_\_\_ Sec. *6* Twp. *27* R. *8*  
 Well No. *3 Lucas*  
*Brennan & Wipon & Inland Oil Co.* Company  
 \_\_\_\_\_ Contractor

FIRST REPORT

*660'* Ft. from N. Line  
 \_\_\_\_\_ Ft. from S. Line  
*660'* Ft. from E. Line  
 \_\_\_\_\_ Ft. from W. Line

SECTION PLAT

	0		

Location \_\_\_\_\_  
 Rig up \_\_\_\_\_  
 Drilling and Remarks:

*Rig.*

RECORD

Cased \_\_\_\_\_ in., \_\_\_\_\_ ft.  
 Sand \_\_\_\_\_  
 Gas \_\_\_\_\_  
 Oil \_\_\_\_\_  
 Total Depth \_\_\_\_\_

PRODUCTION

1st 24 hrs. Nat. \_\_\_\_\_  
 1st 24 hrs. after shot \_\_\_\_\_  
 Gas \_\_\_\_\_ Cu. Ft.  
 Dry Hole \_\_\_\_\_  
 Abandoned \_\_\_\_\_

Date

JAN 27 1922 191 \_\_\_\_\_

M. A. BENEAR

Scout

Map No. K10 Sec. 6 Twp. 27 R. 8

Well No. 3 - Lucas

Brennan + Wixon Company

Contractor

# COMPLETED SECTION PLAT

660 Ft. from N. Line

# ABANDONED

\_\_\_\_\_ Ft. from S. Line

660 Ft. from E. Line

\_\_\_\_\_ Ft. from W. Line

	0		

Location \_\_\_\_\_

Rig up \_\_\_\_\_

Drilling and Remarks:

*sand 2712-24*  
*LDV 92727*

## RECORD

Cased \_\_\_\_\_ in., \_\_\_\_\_ ft.

Sand \_\_\_\_\_

Gas \_\_\_\_\_

Oil \_\_\_\_\_

Total Depth \_\_\_\_\_

## PRODUCTION

1st 24 hrs. Nat. \_\_\_\_\_

1st 24 hrs. after shot \_\_\_\_\_

Gas \_\_\_\_\_ Cu. Ft.

Dry Hole \_\_\_\_\_

Abandoned \_\_\_\_\_

Date

MAY 6 1922

M. A. BENEAR

\_\_\_\_\_ 191 \_\_\_\_\_ Scout