


Form 51-5M-10-26-Mid-West *Summer*  
 Map No. **KANSAS** Sec. *25* Twp. *31* R. *2E*  
 Well No. *8 - River Bed* Farm  
*Rocana Pit Corp.* Company

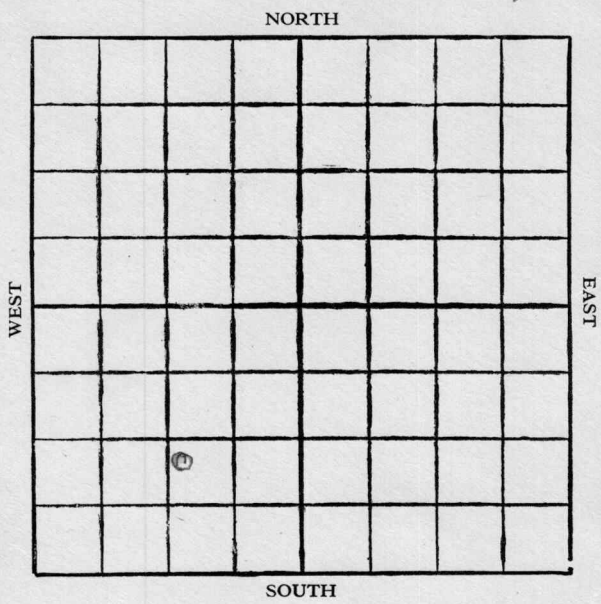

Location .....

Drilling Remarks .....

.....

.....

Rig Up .....

Drilling Remarks .....

.....

.....

**RECORD**

Cased ..... in. .... ft.

Sand .....

Gas .....

Oil .....

Total Depth .....

**PRODUCTION**

1st 24 hrs. Nat. ....

1st 24 hrs. after shot .....

Gas ..... cu. ft.

Dry Hole .....

Abandoned .....

*Summer*

Map No. KANSAS Sec. 25 Twp. 31 R. 2E


Well No. 8 - River Bed Farm  
Rocana Pet Company

..... Ft. from N. Line

995 Ft. from S. Line

1285 Ft. from E. Line

..... Ft. from W. Line

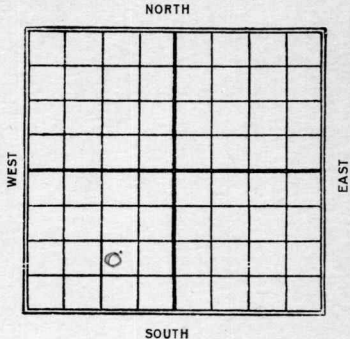

1927

Date

REPORT

<u>4/6</u>	<u>Driving piles</u>	
<u>4/13</u>		
<u>4/20</u>	<u>Driving piles - S.D. high water</u>	
<u>4/27</u>	<u>Shut down</u>	
<u>5/4</u>		
<u>5/11</u>	<u>Piles</u>	
<u>5/25</u>	<u>—</u>	<u>9/14 - Piles</u>
<u>6/1</u>	<u>—</u>	<u>9/20 —</u>
<u>6/8</u>	<u>—</u>	<u>9/28 —</u>
<u>6/15</u>	<u>—</u>	<u>10/5 —</u>
<u>6/22</u>	<u>—</u>	<u>10/12 —</u>
<u>6/29</u>	<u>—</u>	<u>10/19 —</u>
<u>7/6</u>	<u>—</u>	<u>10/26 —</u>
<u>7/13</u>	<u>—</u>	<u>11/2 —</u>
<u>7/20</u>	<u>—</u>	<u>11/9 —</u>
<u>7/27</u>	<u>—</u>	<u>11/16 —</u>
<u>8/3</u>	<u>—</u>	<u>11/22 —</u>
<u>8/10</u>	<u>—</u>	<u>11/29 —</u>
<u>8/17</u>	<u>—</u>	<u>12/7 —</u>
<u>8/24</u>	<u>—</u>	<u>12/14 —</u>
<u>8/31</u>	<u>—</u>	<u>12/21 —</u>
<u>9/7</u>	<u>—</u>	<u>12/28 - Delg 1085-</u>

1928

1/4 - Location

1/11 - Piles (last weeks report in error)

1/18 \_\_\_\_\_

1/25 \_\_\_\_\_

1/31 - Piles

2/15 \_\_\_\_\_

2/22 \_\_\_\_\_

2/29 \_\_\_\_\_

3/7 \_\_\_\_\_

3/14 \_\_\_\_\_

3/21 \_\_\_\_\_

3/28 \_\_\_\_\_

4/4 \_\_\_\_\_

4/11 \_\_\_\_\_

4/18 - Rig

4/25 - Spud 205

5/2 - Arlg - 1005

5/9 - T.D. 1500 - u.R. 8"

5/16 - Top sand 1835 - T.D. 1876

no test -

5/23 - Top stalnacker 1835

T.D. 1879 in sand

shot 50 gts 1860 - 1879

swabbed 284 bbls

30 bbls water 19 hrs

Map No. KANSAS Sec. 25 Twp. 31 R. 2E7

Well No. J. River Bed

Roxana Pet. Corp. Company

Contractor

SECTION PLAT

----- Ft. from N. Line

995 Ft. from S. Line

1285 Ft. from E. Line

----- Ft. from W. Line

	0		

FIRST REPORTS

Location -----

Rig up -----

Drilling and Remarks:

*Driving piles*

RECORD

Cased ----- in., ----- ft.

Sand -----

Gas -----

Oil -----

Total Depth -----

PRODUCTION

1st 24 hrs. Nat. -----

1st 24 hrs. after shot -----

Gas ----- Cu. Ft.

Dry Hole -----

Abandoned -----

Date

APR 6 1927

S. J. LEWIS

192

Scout

Map No. **KANSAS** Sec. 25 Twp. 31 R. 2E

Well No. 8 River Bed

Roxana P. & Co. Inc. Company

Contractor

**SECTION PLAT**

----- Ft. from N. Line

995 Ft. from S. Line

1285 Ft. from E. Line

----- Ft. from W. Line

	0		

**COMPLETED**

**RECORD**

Location -----

Cased ----- in., ----- ft.

Rig up -----

Sand -----

Drilling and Remarks:

Gas -----

Top Stratocoker Sand  
1835

Oil -----

Total Depth -----

TII in sand 1879

Shot 50 gts 1860-  
1879

swatted 284 gts  
oil 30 gts water

**PRODUCTION**

1st 24 hrs. Nat. -----

1st 24 hrs. after shot -----

Gas ----- Cu. Ft.

Dry Hole -----

Abandoned -----

19 hrs.  
Date

**MAY 23 1928** **S. J. LEWIS** Scout