FORM 51 25M 3-49 PETROL


KANSAS

Barton

Section 15 Township 20 Range 12W

Well No. #1 Hulme

Company Lewis Drlg. Company

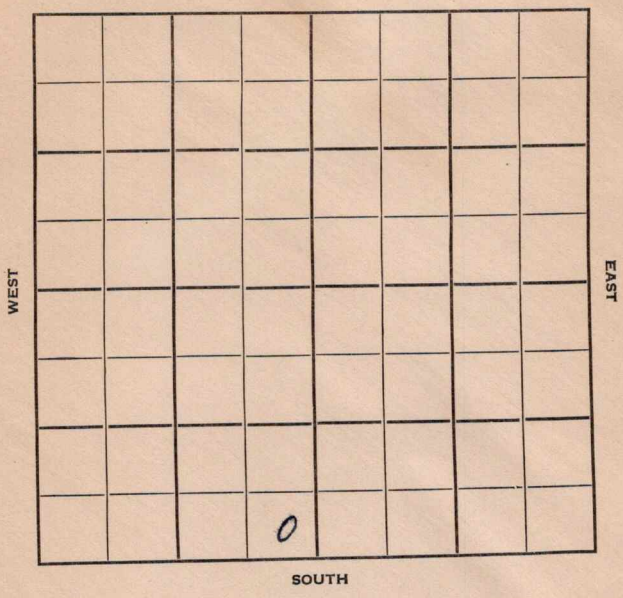

FORM 252-B
10M 8-51 TPCO.

Barton KANSAS ✓

Sec. 15 Twp. 20 R. 12W

Well No. #1 Hulme Farm

Lewis Drlg. Company

Lewis Drlg. Contractor


Ft. from N. Line

330 Ft. from S. Line

330 Ft. from E. Line

Ft. from W. Line

SE SE SW

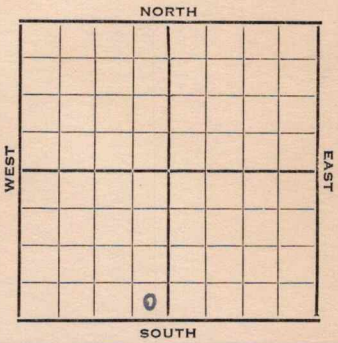

1953 Elev. 1822' REPORT

3/18 Spud 3-16-53
3/26 8" @ 183 Lans 3142'
Drlg. 3228'
4/2 Arb 3372
RTD 3390
5" @ 3389
4/9 CO" Testing
4/16 Testing
4/23 "
4/29 Spud 3-16-53
Oil Well
TD 3397'
8" @ 183'
Heeb 3000, Br. Lime 3124, Lans 3142,
Arb 3372,
TD 3390'
5" @ 3389'
CO to 3390
DD 3391 FU 100' free oil S/ 5 boph
24/ 3383-85 S/ 1½ boph S/ 2 boph
1000 A S/ 6 boph DD 3397
DST 3379-86 opn 1 hr, rec 75' gas,
45' hocm 500 A 3 boph
Comp. 185 bopd.

COMPLETED

FORM 275 FOR SALE BY KANSAS BLUE PRINT CO.


County Barton State Kansas

Sec. 15 (Blk. Twp.) 20 (Sur. Rge.) 12W Map No.

Operator Lewis Drlg.

Well No. 1 Farm Hulme

Elev. Location SE SE SW

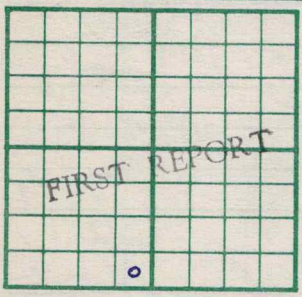

330 Ft. From S Line SW

330 Ft. From E Line Quarter

1st. Report MAR 18 1953

Completion

Remarks Lewis Drlg. - Contr.

Spudding Date 3-16-53

Drlg. Data

J. G. McGEHEE

FORM 275 FOR SALE BY KANSAS BLUE PRINT CO.

County Barton State Kansas

Sec. 15 (Blk. Twp.) 20 (Sur. Rge.) 12W Map No.

Operator Lewis Drlg.

Well No. 1 Farm Hulme

Elev. 1822 Location SE SE SW



330 Ft. From S Line SW

330 Ft. From E Line Quarter

1st. Report

Completion APR 29 1953

Remarks

Lewis Drlg. - Contr.

Spudding Date 3-16-53

Drlg. Data Oil well TD 3397

8" @ 183 Heeb. 3000 Br. lime 3124

Lans. 3142 Arb. 3372 TD 3390 5" @ 3389

CO to 3390 DD 3391 FU 100' free oil

S/ 5 boph 24/ 3383-85 S/ 1½ boph

S/ 2 boph 1000 A S/ 6 boph DD 3397

DST 3379-86 open 1 hr. Rec. 75' gas

45' hocm 500 A 3 boph

Comp. 185 bopd

J. G. McGEHEE