


KANSAS

Barton

Section 15 Township 20 Range 12-W

Well No. #1 Hulme

Company Fred Rust

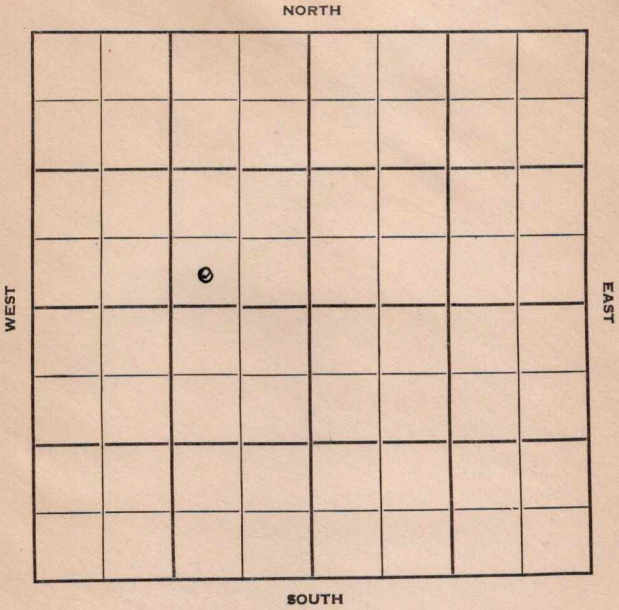

Barton

KANSAS

Sec. 15 Twp. 20 R. 12W

Well No. #1 Hulme Farm

Fred Rust Company

Contractor


Ft. from N. Line

330' Ft. from S. Line

990' Ft. from E. Line

Ft. from W. Line

SW SE NW

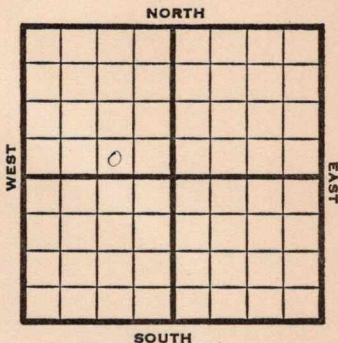

1950

Elev. 1839'

REPORT

3/1

Spud 2-22-50
8-5 8" @ 250'

Anhy 628'

Drlg. 2097'

3/8

TD 3458'
8 5/8" @ 250'

Heeb 3037'

Br L 3154'

Lans 3173'

Cong 3418'

Arb. 3429'

D&A

Aband.

ABANDONED

Kansas

Map No. _____ Sec. 15 Twp. 20 R. 12WWell No. 1 HulmeFred Rust Company

Contractor

SW SE NW

E 1.1839

SECTION PLAT

	0		

FIRST REPORT

_____ Ft. from N. Line

330 Ft. from S. Line990 Ft. from E. Line

_____ Ft. from W. Line

Barton County

Location _____

Rig up _____

Drilling and Remarks:

Spud 2-22-50

8 5/8" @ 250

Anhy 628

drlg. 2097

RECORD

Cased _____ in., _____ ft.

Sand _____

Gas _____

Oil _____

Total Depth _____

PRODUCTION

1st 24 hrs. Nat. _____

1st 24 hrs. after shot _____

Gas _____ Cu. Ft.

Dry Hole _____

Abandoned _____

Date

MAR 1 1950 19

J. E. TYRA

Scout

Kansas

Map No. _____ Sec. 15 Twp. 20 R. 12WWell No. 1 Hulme

_____ Fred Rust _____ Company

_____ Contractor


SW SE NW

E1 1839
SECTION PLAT

_____ Ft. from N. Line

330 Ft. from S. Line990 Ft. from E. Line

_____ Ft. from W. Line

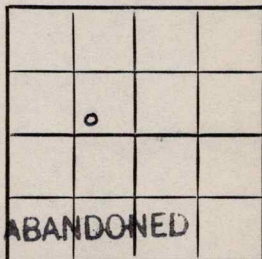

Barton County

Location _____

Rig up _____

Drilling and Remarks:

8 5/8" @ 250Hulb 3037Br L. 3154Lans 3173Cong 3418amb 3429

Date

D & A.

RECORD

Cased _____ in., _____ ft.

Sand _____

Gas _____

Oil _____

Total Depth 3458

PRODUCTION

1st 24 hrs. Nat. _____

1st 24 hrs. after shot _____

Gas _____ Cu. Ft.

Dry Hole _____

Abandoned _____

MAR 8 1950 19

J. E. TYRA Scout