


Section 15 Township 20 Range 12W

Well No. 2 Hulme

Company Lewis Drlg.

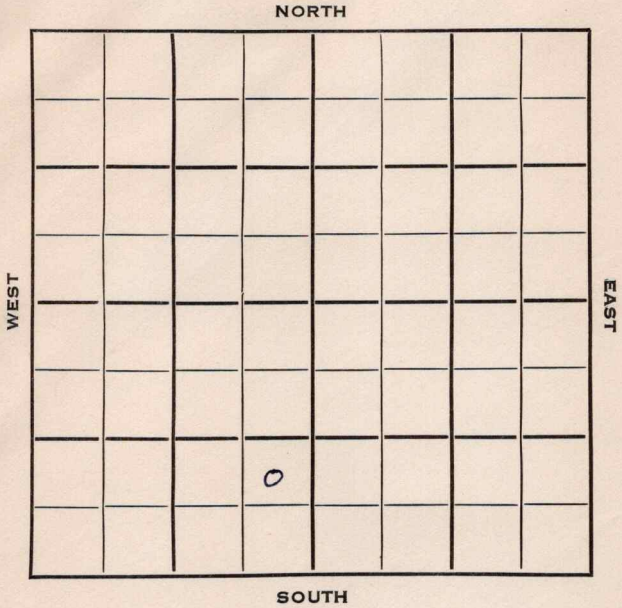

Barton

KANSAS ✓

Sec. 15 Twp. 20 R. 12 W

Well No. # 2 Hulme Farm

Lewis Drlg. Company

Lewis Drlg. Contractor

SW Buckbee Pool


Ft. from N. Line

990 Ft. from S. Line

330 Ft. from E. Line

Ft. from W. Line

NE SE SW

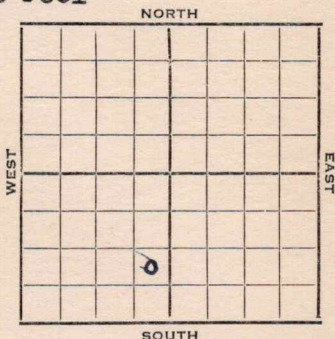

1953 Elev. 1827' REPORT

4/8 Spud 4-2-53  
8" @ 174  
Drlg. 2705'

4/15 Spud 4-2-53  
D&A  
TD 3436  
8" @ 174  
Heeb 3020, Br lime 3138, KC 3158,  
Arb. 3403  
DST 3405-21, opn 1/2 hrs., rec. 6' mud  
TD 3436  
D&A

ABANDONED



