DX 78-1


BARTON

KANSAS

Section 16 Township 20S Range 12W

Well No. #1 Hulme "I"

Company Petroleum, Inc.

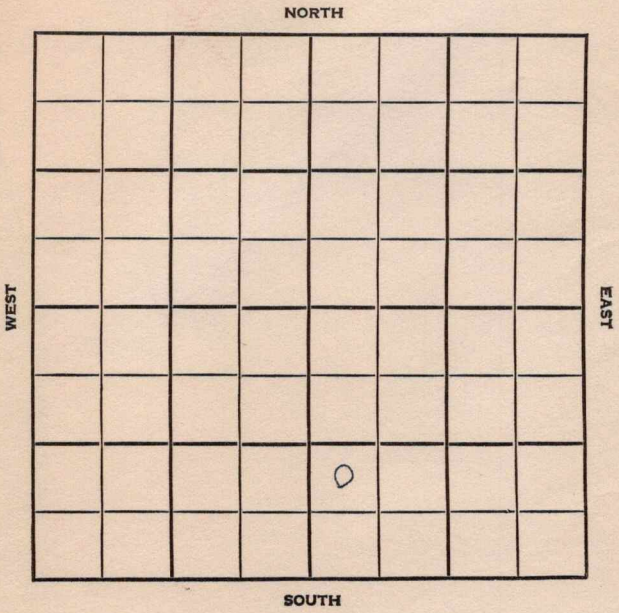

Barton KANSAS

SEC.	TWP.	R.
16	20S	12W

WELL NO.

1 Hulme "I" FARM
COMPANY

Petroleum, Inc.
CONTRACTOR

(WILDCAT)


_____ FT. FROM N. LINE

_____ FT. FROM S. LINE

_____ FT. FROM E. LINE

_____ FT. FROM W. LINE

NW SW SE

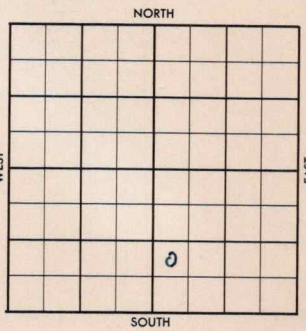

1 Mile - SDX

1956	ELEVATION 1834 REPORT
6-20	Comm. 6-13-56 8" @ 244 W/200 DST 3189-3252, op 1 hr., gas 6", flo MC oil in 45", clean oil in 52", BHP 1160#: DST 3228-52 H. 3015', Tr. 3035', Dg. 3046', B.L. 3136', L. 3156'
9-5	Comm 6-13-56 Tops: H 3015, Tr 3035, Dg 3046, Bl 3136, L 3150, Cherty 3395 TD 3465 8" @ 244 w/200 DST 3189-3252 op 1 hr, gas 6" flo mC oil in 45" clean oil in 52" BHP 1160# DST 3228-52 op 75" rec 150' VHO & GCM + 120' mw 1150/30" DST 3276-98 30" rec 20' GCM ~~km~~ 1150/30" DST 3303-50 30" rec 15' GCM (SSO) 150/20"

OVER

FORM 504-5 SUNRAY

742443

1956
9-5 cont
DST 3152-79 45" G in 2" ga
3,690 M rec 60' M & GCSW BHP
1230 20"
5 1/2" @ 3400 w/100
CO 3334 16/3288-92 tst 1/2 BFPH
90% wtr PB 3270 40/3238-49
flwd 102 BI PH 9% wtr
BH BO 1770 Flw 1696 BOPD
16% wtr Grav 36

COMPLETED

FORM 513 SUNRAY

County Barton Elev.

Sec. 16 Twp. 20S Rge. 12W

Company Petroleum, Inc.

Farm Name Hulme No. 1


TOPS	DEPTH	LOG	DATUM
Anh.			
Tp.			
H.	3015		
Tr.	~~3032~~		
Dg.	3046		
Bl.	~~3136~~		
L.	3136		
K.C.			
B.K.C.			
Ce.			
C.			
M.			
M.			
K.			
Mz.			
Mo.			
V.			
S.			
S.			
A			
R.			
Pe.			
G.			
T.D.			

Loc. in Sec. NW SW SE

Geol.

Contr.

Pool 1 mi. WC

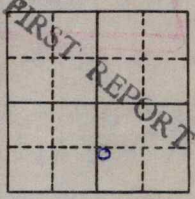

Date Comm. 6-13-56

JUN 20 '56

8" 24# w/200; DST 3189-3252 op 1 hr., gas 6", flo MC oil in 45", clean oil in 52", BHP 1160#; DST 3228-52

Co. Lse. No. Sec. T. R.

FORM 513 SUNRAY

County Barton Elev. 1834

Sec. 16 Twp. 20S Rge. 12W

Company Petroleum, Inc.

Farm Name Hulme "I" No. 1

TOPS	DEPTH	LOG	DATUM
Anh.			
Tp.			
H.	3015		
Tr.	~~3038~~		
Dg.	3046		
Bl.	~~3136~~		
L. 3150	~~3156~~		
K.C.			
B.K.C.			
Ce.			
C. Cherty	3393		
M.			
M.			
K.			
Mz.			
Mo.			
V.			
S.			
S.			
A			
R.			
Pe.			
G.			
T.D.	3465		

Loc. in Sec. NW SW SE

Geol.

Contr.

Pool 1 mi. WC

COMPLETE SEP 5 '56

Date Comm. 6-13-56

8" 244 w/200; DST 3189-3252 op 1 hr., gas 6", flo MC oil in 45", clean oil in 52", BHP 1160#; DST 3228-52 JUN 27 '56 op 75" rec 150' VHO&GCM + 120' MW 1150/30" DST 3276-98 30" rec 30' GCM 1150/30" DST 3303-50 30" rec 15' GCM (SSO) 150/20" 5½ DST 3152-79 45" g in 2" ga 3,690 M. rec 60' M&GCSW BHP 1230 /20" 5½ @ 3400/100

FORM 513-1 SUNRAY 16-20-12W NW SW SE

JUL 3 '56 JUL 11 '56 CO 3334 16/3288
-92 1/4 tst 1/2 BFph 90% wtr PB 3270 40/3238-49
1/4 Flwd 102 BFph 9% wtr

JUL 18 '56 JUL 25 '56 AUG 1 '56 AUG 8 '56
AUG 15 '56 AUG 22 '56 AUG 29 '56 SEP 5 '56

BH Bomb Flw 1696 Bopd
16% wtr grav 36°

16-20-12W NW SW SE