


Kansas

Map No. _____ Sec. *25* Twp. *31* R. *2E*

Well No. *4 - Putter* Farm _____

Polana Pet Corp. Company _____

NORTH

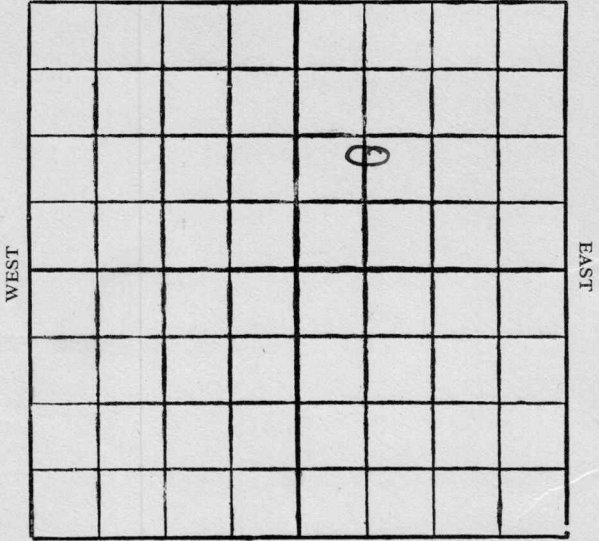

SOUTH

Location _____

Rig Up _____

Drilling Remarks _____

Drilling Remarks _____

RECORD

PRODUCTION

Cased _____ in. _____ ft.

1st 24 hrs. Nat. _____

Sand _____

1st 24 hrs. after shot _____

Gas _____

Gas _____ cu. ft.

Oil _____

Dry Hole _____

Total Depth _____

Abandoned _____

Map No. KANSAS Sec. 25 Twp. 21 R. 2E

Well No. H RUTTER

Roxana P. & Co. Inc. Company

Contractor

SECTION PLAT

----- Ft. from N. Line

1074 Ft. from S. Line

----- Ft. from E. Line

660 Ft. from W. Line

		o	
		o	

FIRST REPORTS

Location ✓-----

Rig up -----

Drilling and Remarks:

RECORD

Cased ----- in., ----- ft.

Sand -----

Gas -----

Oil -----

Total Depth -----

PRODUCTION

1st 24 hrs. Nat. -----

1st 24 hrs. after shot -----

Gas ----- Cu. Ft.

Dry Hole -----

Abandoned -----

Date

FEB 16 1927

S. J. LEWIS Scout

Map No. KANSAS Sec. 25 Twp. 31 R. 2E

Well No. 4 Rutter

Roxana P & O Corp Company

Contractor

SECTION PLAT

----- Ft. from N. Line

1074 Ft. from S. Line

----- Ft. from E. Line

660 Ft. from W. Line

		O X	

COMPLETED

Location -----

Rig up -----

Drilling and Remarks:

T.S. 1847
O.C. 1879
T.D. 1909 1/2
Blow 80 gts 1870 &
1909 1/2
Swabbed 894
8 1/2 - 24 hrs

RECORD

Cased ----- in., ----- ft.
 Sand -----
 Gas -----
 Oil -----
 Total Depth -----

PRODUCTION

1st 24 hrs. Nat. -----
 1st 24 hrs. after shot -----
 Gas ----- Cu. Ft.
 Dry Hole -----
 Abandoned -----

Date

APR 13 1927

S. J. LEWIS

Scout