


Well No. 6-B-Shore Farm
Rotana Ref Carb Company

WEST

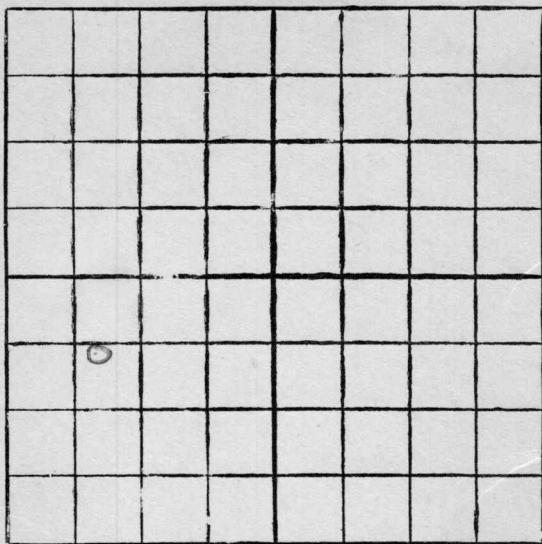

EAST

SOUTH

Drilling Remarks

Drilling Remarks

PRODUCTION

Total Depth.....

Abandoned -----


Map No. KANSAS Sec. 25 Twp. 31 R. 2E
 Well No. 6-B-Shore Farm
Roxana, Pet Company

695 Ft. from N. Line

_____ Ft. from S. Line

_____ Ft. from E. Line

837 Ft. from W. Line

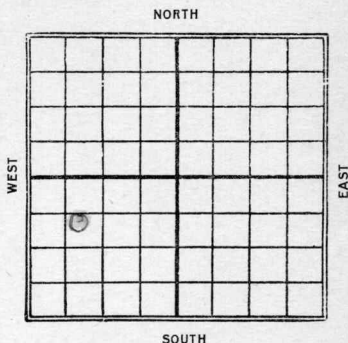

SOUTH

Date

REPORT

2/15	R.O.G.
2/22	Bldg rig
2/29	Spud — 205
3/7	Drilling 1130
3/14	" 11640
3/21	Top sand 1845 - T.D. 1896 - 10 bailers water per hrs
3/28	P.B. to 1891 - Cleaning out -
4/4	No test
4/11	P.B. to 1888 - 1½ bailers oil and 1½ bailers water -
4/18	12 bailers water per hour -
4/25	P.B. to 1873 pulling big pipe
5/2	T.D. 1873 - Cementing
5/9	Plugging back to 1867 -
5/16	T.D. 1896 H. & A.

Map No. **KANSAS** Sec. 25 Twp. 31 R. 25

Well No. 6 B Shree

Roxana Pet. Corp. Company

Contractor

SECTION PLAT

695 Ft. from N. Line

_____ Ft. from S. Line

_____ Ft. from E. Line

137 Ft. from W. Line

0			

FIRST REPORTS

Location _____

Rig up _____

Drilling and Remarks:

ROY

RECORD

Cased _____ in., _____ ft.

Sand _____

Gas _____

Oil _____

Total Depth _____

PRODUCTION

1st 24 hrs. Nat. _____

1st 24 hrs. after shot _____

Gas _____ Cu. Ft.

Dry Hole _____

Abandoned _____

Date

FEB 15 1928
192

S. J. LEWIS Scout

Map No **KANSAS** Sec. 25 Twp. 31 R. 2E

Well No. 6-B Shore

Roxana P.D. Corp. Company

Contractor

SECTION PLAT

o			

695 Ft. from N. Line

----- Ft. from S. Line

----- Ft. from E. Line

137 Ft. from W. Line

ABANDONED

Location -----

Rig up -----

Drilling and Remarks:

TD 1896

DYA

RECORD

Cased ----- in., ----- ft.

Sand -----

Gas -----

Oil -----

Total Depth -----

PRODUCTION

1st 24 hrs. Nat. -----

1st 24 hrs. after shot -----

Gas ----- Cu. Ft.

Dry Hole -----

Abandoned -----

Date

MAY 16 1928

S. J. LEWIS

Scout

MAP NO. K1 KANSAS SEC. 25 TWP. 31S R. 2E

WELL NO. 6 (B) Moore

Ropane COMPANY

CONTRACTOR

SECTION PLAT

_____ FT. FROM N. LINE

_____ FT. FROM S. LINE

_____ FT. FROM E. LINE

_____ FT. FROM W. LINE

RECORD

LOCATION _____

CASED _____ IN. _____ FT.

RIG UP _____

SAND _____

DRILLING AND REMARKS:

GAS _____

OIL _____

TOTAL DEPTH 1891

PRODUCTION

1ST 24 HRS. NAT. _____

1ST 24 HRS. AFTER SHOT _____

GAS _____ CU. FT.

DRY HOLE ☒

ABANDONED ☒

DATE

4/25

192

8

SCOUT

837' N2-
695' N2-SW
no show
1896