
Sumner KANSAS

SECTION 25 TOWNSHIP 31 RANGE 2 E

WELL NO. #1 Sleigh

COMPANY Kriswell Drlg.

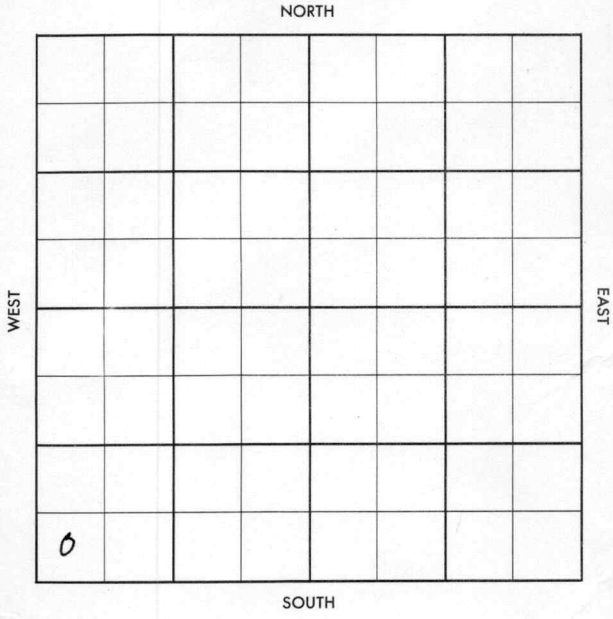

FORM 504-3 SUNRAY

Summer KANSAS

SEC.	TWP.	R.
25	31	2E

WELL NO. #1 Sleigh FARM

COMPANY Kriswell Drlg

CONTRACTOR Co. Tools
Churchill


_____ Ft. from N. Line

_____ Ft. from S. Line

_____ Ft. from E. Line

_____ Ft. from W. Line

SW SW SW

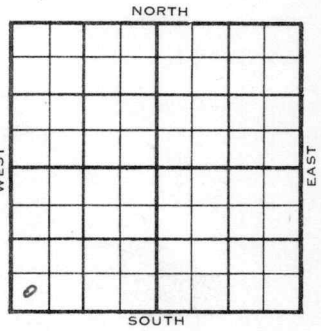

1955	ELEVATION 1156'	REPORT
10/19	Cellar & Pits	
10/26	Comm 10-19-55 8 5/8" @ 75 Stal 1886 KC 2220 TD 2275 DST 1888-1908 open 1 hr rec 20' mud 490/20" D & A	

ABANDONED

DX-78

FORM 513 REV. SUNRAY

County Sumner Elev.

Sec. 25 Twp. 31 Rge. 2E

Company Kriewell Drlg.

Farm Name Sleigh No. 1

TOPS	DEPTH	LOG	DATUM
Anh.			
Tp.			
H.			
Tr.			
Dg.			
B.L.			
L.			
K.C.			
B.K.C.			
Ce.			
C.			
M.			
M.			
K.			
Mz.			
Mo.			
V.			
S.			
S.			
A			
R.			
P€.			
G.			
T.D.			

Loc. in Sec. SW SW SW

Geol.

Contr. Co. tools

Pool Churchhill

FIRST REPORT
OCT 19 1955

Date Comm.

Cellar & pits

Co. Lse. No. Sec. T. R.

FORM 513 REV. SUNRAY

County Sumner Elev. 1156

Sec. 25 Twp. 31 Rge. 2E

Company Kriswell Drlg.

Farm Name Sleigh No. 1

TOPS	DEPTH	LOG	DATUM
Anh.			
T.P.			
H. Stub	1886		730
Tr.			
Dg.			
B.L.			
L.			
K.C.	2320		1064
B.K.C.			
Ce.			
C.			
M.			
M.			
K.			
Mz.			
Mq.			
V.			
S.			
S.			
A			
R.			
P€.			
G.			
T.D.	2375		

Loc. in Sec. SW SW SW

Geol.

Contr. Co. tools

Pool Churchhill

ABANDONED

o

Date Comm. 10-19-55 OCT 26 1955

8 5/8" @ 75 DST 1888-1908 open 1 hr.

rec. 20' mud 490/20"

D & A

Co. Lse. No. Sec. T. R.