


Map No. \_\_\_\_\_ Sec. 25 Twp. 31 R. 2E  
 Well No. 2-Sleigh Farm \_\_\_\_\_  
Potana Pet Corp. Company \_\_\_\_\_

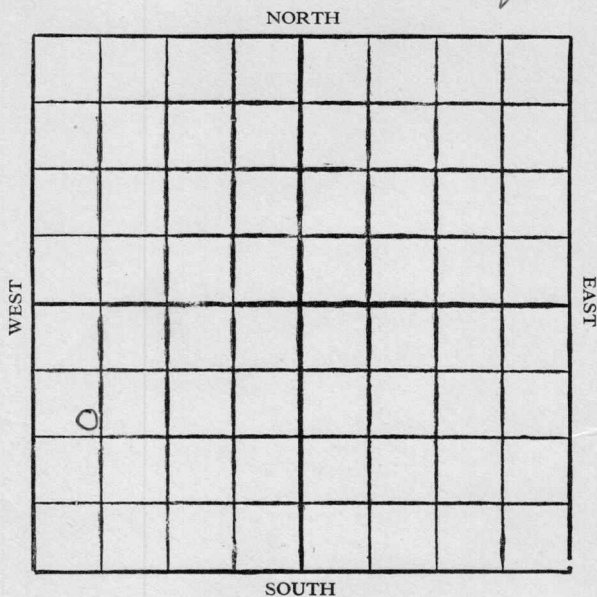

Location \_\_\_\_\_  
 Drilling Remarks \_\_\_\_\_

Rig Up \_\_\_\_\_  
 Drilling Remarks \_\_\_\_\_

RECORD


Cased \_\_\_\_\_ in. \_\_\_\_\_ ft.  
 Sand \_\_\_\_\_  
 Gas \_\_\_\_\_  
 Oil \_\_\_\_\_  
 Total Depth \_\_\_\_\_

PRODUCTION

1st 24 hrs. Nat. \_\_\_\_\_  
 1st 24 hrs. after shot \_\_\_\_\_  
 Gas \_\_\_\_\_ cu. ft.  
 Dry Hole \_\_\_\_\_  
 Abandoned \_\_\_\_\_

Map No. \_\_\_\_\_ Sec. 25 Twp. 31 R 2E  
 Well No. 2 - Sleigh Farm \_\_\_\_\_  
Robana Pet Company \_\_\_\_\_

NORTH

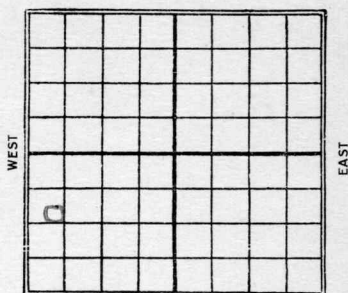

\_\_\_\_\_ Ft. from N. Line

1620 Ft. from S. Line

\_\_\_\_\_ Ft. from E. Line

600 Ft. from W. Line

SOUTH

1927

Date

REPORT

| Date | REPORT               |
|------|----------------------|
| 4/13 | Location             |
| 4/20 | —                    |
| 4/27 | —                    |
| 5/4  | Rig                  |
| 5/11 | Rigging up           |
| 5/18 | Spud                 |
| 5/25 | Drill 1220           |
| 6/1  | top sd. 1854         |
| 6/8  | T.S. 1854            |
|      | Oil 1861 - T.D. 1897 |
|      | shot 70 gts 1861-97  |
|      | 437 bbls.            |

Map No. **KANSAS** Sec. 25 Twp. 31 R. 2E

Well No. 2 Bleigh

Rotana Pet. Corp. Company

Contractor

### SECTION PLAT

----- Ft. from N. Line

1620 Ft. from S. Line

----- Ft. from E. Line

600 Ft. from W. Line

|   |  |   |  |
|---|--|---|--|
|   |  |   |  |
|   |  |   |  |
| o |  | c |  |
|   |  |   |  |

### FIRST REPORTS

Location ✓

Rig up -----

Drilling and Remarks:

### RECORD

Cased ----- in., ----- ft.

Sand -----

Gas -----

Oil -----

Total Depth -----

### PRODUCTION

1st 24 hrs. Nat. -----

1st 24 hrs. after shot -----

Gas ----- Cu. Ft.

Dry Hole -----

Abandoned -----

Date

APR 13 1937

192

S. J. LEWIS

Scout

Map No. KANSAS Sec. 25 Twp. 31 R. 2E

Well No. 2. Steigh

Roxana P & Co. Company

Contractor

## SECTION PLAT

Ft. from N. Line

1620 Ft. from S. Line

Ft. from E. Line

600 Ft. from W. Line

|  |  |  |  |
|--|--|--|--|
|  |  |  |  |
|  |  |  |  |
|  |  |  |  |
|  |  |  |  |

COMPLETED

Location

Rig up

Drilling and Remarks:

T.S. 1854

O.C. 1861

T.D. 1897

Gas 709 ts. 1861

1897

4378 ft.

## RECORD

Cased \_\_\_\_\_ in., \_\_\_\_\_ ft.

Sand \_\_\_\_\_

Gas \_\_\_\_\_

Oil \_\_\_\_\_

Total Depth \_\_\_\_\_

## PRODUCTION

1st 24 hrs. Nat. \_\_\_\_\_

1st 24 hrs. after shot \_\_\_\_\_

Gas \_\_\_\_\_ Cu. Ft.

Dry Hole \_\_\_\_\_

Abandoned \_\_\_\_\_

Date

JUN 8

1925

S. J. LEWIS

Scout