
Form 51—5M—10-26—Mid-West

KANSAS

Map No. ..... Sec. 25 Twp. 31 R. 2E

Well No. 4 - Sleigh Farm

Pecana Pet Corp Company

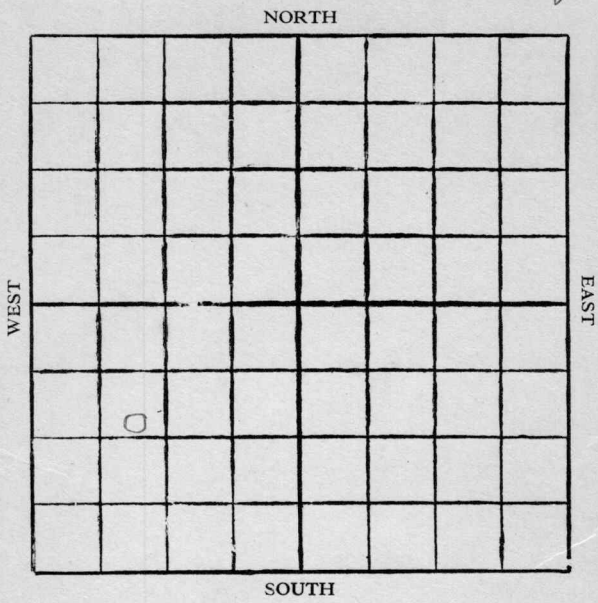

Location	Rig Up
Drilling Remarks	Drilling Remarks
RECORD	PRODUCTION
Cased ..... in. ..... ft.	1st 24 hrs. Nat.
Sand	1st 24 hrs. after shot
Gas	Gas ..... cu. ft.
Oil	Dry Hole
Total Depth	Abandoned

Form 252A—5M—4-27—27425

Map No. KANSAS Sec. 25 Twp. 31 R. 2E

Well No. 4—Sleigh Farm


Rosana Pet. Company

1010 Ft. from N. Line

..... Ft. from S. Line

..... Ft. from E. Line

990 Ft. from W. Line

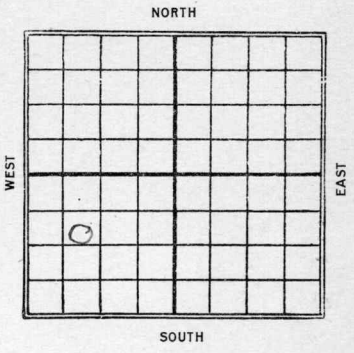

1928

Date	REPORT
2/15	T. D. G.
2/22	Bldg rig
2/29	Rigging up-
3/7	Drlg 810-
3/14	" 1560
3/21	Top Sand 1847—T.D. 1894— 700' oil in hole—
3/28	5½ 1847- T.D. 1894 P.B. 1892 50 sks 1867-92 swabbed 20 bbls

Form 26-1M Bks. 8-23-11959.


Map No. KANSAS Sec. 25 Twp. 31 R. 24

Well No. 4 Sleigh

Roxana Pet. Corp'n Company

Contractor

SECTION PLAT

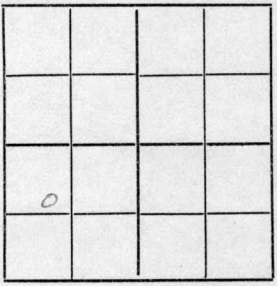

1010 Ft. from N. Line

Ft. from S. Line

Ft. from E. Line

990 Ft. from W. Line

FIRST REPORTS

Location

Rig up

Drilling and Remarks:

R.O.G.

RECORD

Cased in., ft.

Sand

Gas

Oil

Total Depth

PRODUCTION

1st 24 hrs. Nat.

1st 24 hrs. after shot

Gas Cu. Ft.

Dry Hole

Abandoned

Date

FEB 15 1928 192

S. J. LEWIS Scout

Form 26—1M Bks.—3-28—11959.


Map No. KANSAS Sec. 25 Twp. 31 R. 27

Well No. 4 Sleigh

Roxana Pet. Corp. Company

Contractor

SECTION PLAT

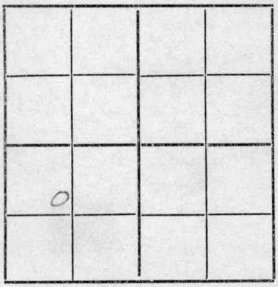

1010 Ft. from N. Line

Ft. from S. Line

Ft. from E. Line

990 Ft. from W. Line

COMPLETED

Location

Rig up

Drilling and Remarks:

TD 1847
TD 1894
PB 1892
50/1867-92.
Swabbed 20 BBLS

RECORD

Cased in., ft.

Sand

Gas

Oil

Total Depth

PRODUCTION

1st 24 hrs. Nat.

1st 24 hrs. after shot

Gas Cu. Ft.

Dry Hole

Abandoned

Date

MAR 28 1928

192

S. J. LEWIS

Scout