


Map No. _____ Sec. 12 Twp. 27 R. 8

Well No. 1 Baldwin Farm

Blue Stem Co. & Co. Company

NORTH

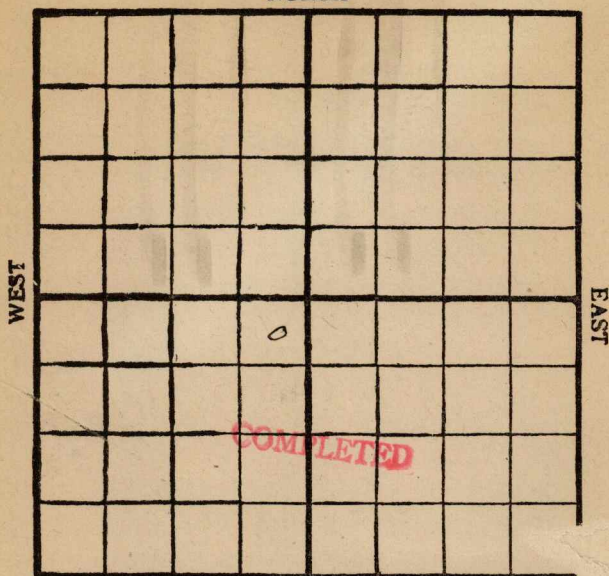

SOUTH

Location -----

Drilling Remarks:

Rig Up -----

Drilling Remarks:

RECORD

Cased----- in.----- ft.

Sand -----

Gas _____

Oil_____

Total Depth -----

PRODUCTION

1st 24 hrs. Nat.-----

1st 24 hrs. after shot-----

Gas ----- cu. ft.

Dry Hole -----

Abandoned -----


Map No. K10 Sec. 12 Twp. 27 R. 8Well No. 1 Baldwin
Blue Stem O & G Company

Contractor

NORTH

WEST

EAST

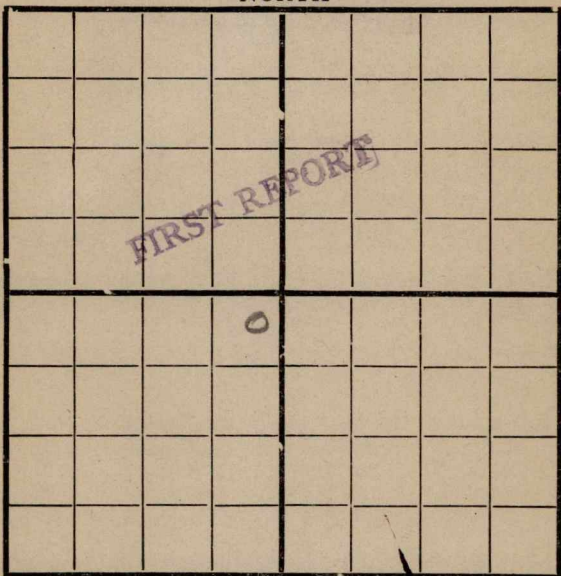

SOUTH

400 N-E

RECORD

Location _____

Cased _____ in., _____ ft.

Rig up _____

Sand _____

Drilling and Remarks:

Gas _____

Oil _____

Total Depth _____

PRODUCTION

1st 24 hrs. Nat. _____

1st 24 hrs. after shot _____

Gas _____ Cu. Ft.

Dry Hole _____

Abandoned _____

Date

Feb 1 1919

Pyle

Scout


Map No. K10 Sec. 12 Twp. 27 R. 8
 Well No. 1 Baldwin
Blue Stem Oil Company

Contractor _____

NORTH

WEST

EAST

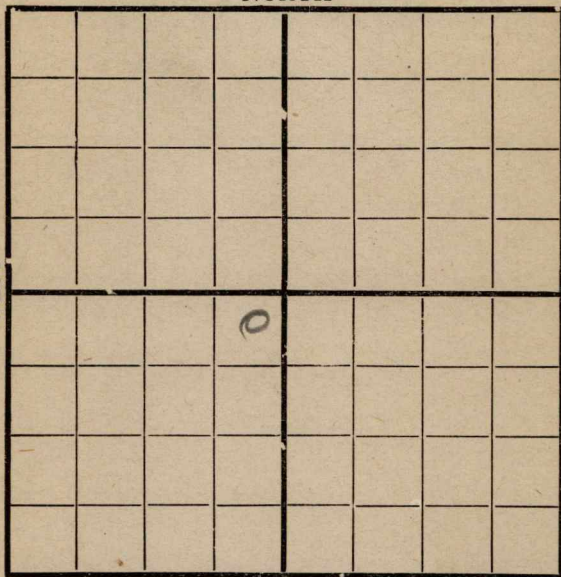

200 N-E SOUTH

Location _____

Rig up _____

Drilling and Remarks:

8' 1/4 @

920

RECORD

Cased _____ in., _____ ft.

Sand _____

Gas _____

Oil _____

Total Depth _____

PRODUCTION

1st 24 hrs. Nat. _____

1st 24 hrs. after shot _____

Gas _____ Cu. Ft.

Dry Hole _____

Abandoned _____

Date

2/4

1919

Pyle


Scout

Map No. K 10 Sec. 12 Twp. 17 R. 8
 Well No. 1 Baldwin
Blue Stem O. & G. Company
 Contractor

NORTH

WEST

EAST

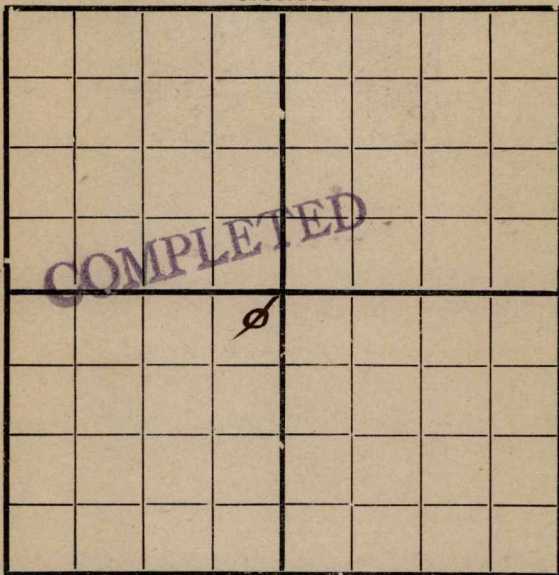

200 N-E SOUTH

Location _____

Rig up _____

Drilling and Remarks:

shale sand @
1140'

RECORD

Cased _____ in., _____ ft.

Sand _____

Gas _____

Oil _____

Total Depth _____

PRODUCTION

1st 24 hrs. Nat. _____

1st 24 hrs. after shot _____

Gas _____ Cu. Ft.

Dry Hole 1200

Abandoned _____

Date


Feb 10 1919 Pyle Scout

Map No. K10 Sec. 12 Twp. 27 R. 8
 Well No. 1 Baldwin
Blue Stem Oil Company
 Contractor

NORTH

WEST

EAST

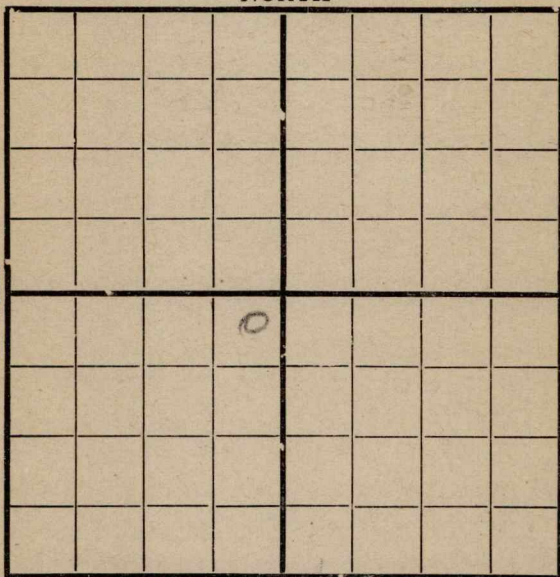

200 N-E SOUTH

Location _____

Rig up _____

Drilling and Remarks:

*I reported
 this well
 dry @ 1200
 but they will
 drill deeper*

RECORD

Cased _____ in., _____ ft.

Sand _____

Gas _____

Oil _____

Total Depth _____

PRODUCTION

1st 24 hrs. Nat. _____

1st 24 hrs. after shot _____

Gas _____ Cu. Ft.

Dry Hole _____

Abandoned _____


Date

2/15

191 *9*

Pyle
 Scout

Map No. K10 Sec. 12 Twp. 27^S R. 8^E
 Well No. 1 Baldwin
Blue Stem Oil Company
 Contractor

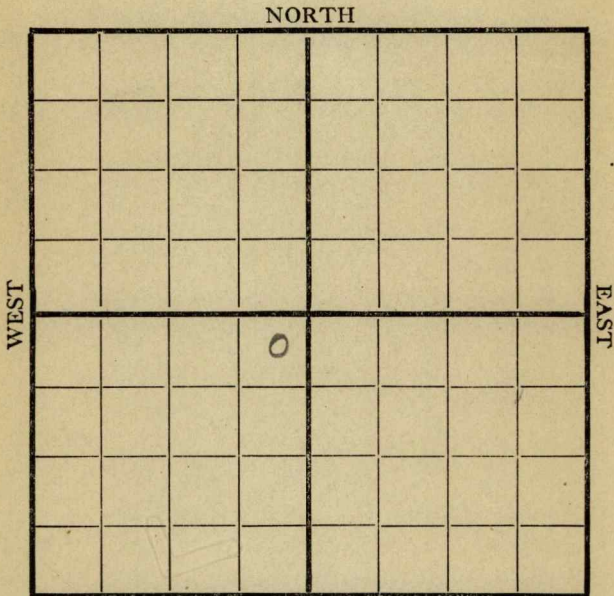

200 N-E

Location _____
 Rig up _____
 Drilling and Remarks:

D. 10 @
1205'
account
lawsuit

RECORD

Cased _____ in., _____ ft.
 Sand _____
 Gas _____
 Oil _____
 Total Depth _____

PRODUCTION

1st 24 hrs. Nat. _____
 1st 24 hrs. after shot _____
 Gas _____ Cu. Ft.
 Dry Hole _____
 Abandoned _____

Date


2/28 1919 Oyle Scout

Map No. *K10* Sec. *12* Twp. *27^S* R. *8^E*
 Well No. *1 Baldwin*
Blue Stem Oil Co. Company
 Contractor

NORTH

WEST

EAST

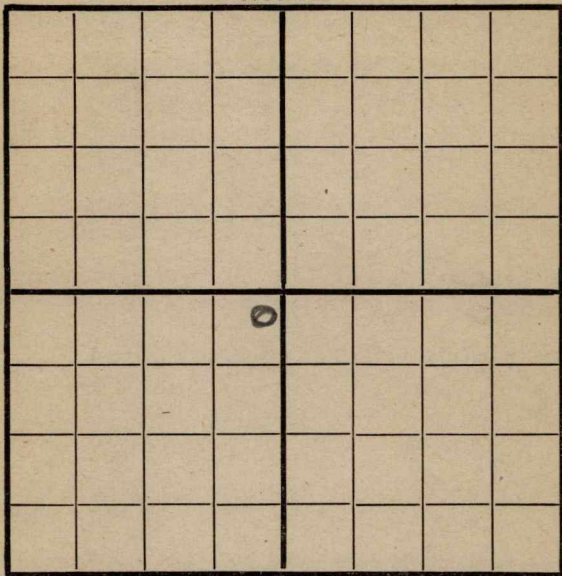

200 N-E SOUTH

RECORD

Location _____

Cased _____ in., _____ ft.

Rig up _____

Sand _____

Drilling and Remarks:

Gas _____

Oil _____

Total Depth _____

PRODUCTION

1st 24 hrs. Nat. _____

1st 24 hrs. after shot _____

Gas _____ Cu. Ft.

Dry Hole _____

Abandoned _____

Date

*3/8*191 *9**Pyle*

Scout


Map No. K10 Sec. 12 Twp. 27³ R. 8^EWell No. 1 Baldwin
Blue Stem O & G Company

Contractor

NORTH

WEST

EAST

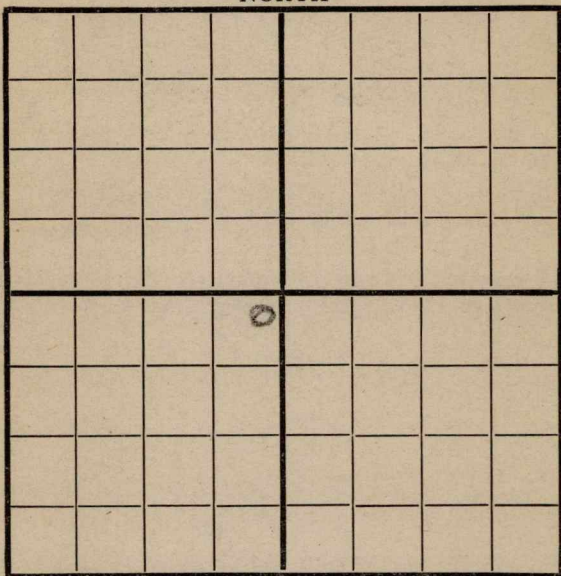

200 N-E SOUTH

Location _____

Rig up _____

Drilling and Remarks:

D. W. @
1205'
Low Suit

RECORD

Cased _____ in., _____ ft.

Sand _____

Gas _____

Oil _____

Total Depth _____

PRODUCTION

1st 24 hrs. Nat. _____

1st 24 hrs. after shot _____

Gas _____ Cu. Ft.

Dry Hole _____

Abandoned _____

Date


3/15

1919

G. W.

Scout

Map No. K10 Sec. 12 Twp. 27 R. 8
 Well No. 1 Baldwin
Blue Stem O & G. Company
 Contractor

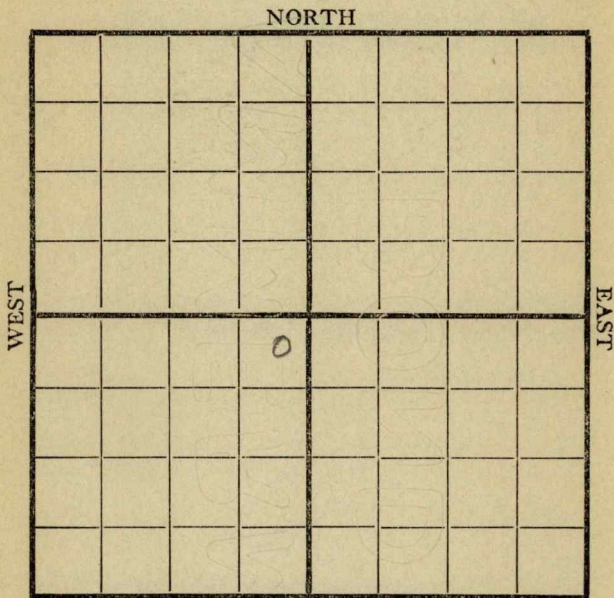

200 N-E

Location _____

Rig up _____

Drilling and Remarks:

S. D @
1205'

RECORD

Cased _____ in., _____ ft.

Sand _____

Gas _____

Oil _____

Total Depth _____

PRODUCTION

1st 24 hrs. Nat. _____

1st 24 hrs. after shot _____

Gas _____ Cu. Ft.

Dry Hole _____

Abandoned _____

Date

3/18 1919


Pyle

Scout

Map No. K10 Sec. 12 Twp. 27 R. 8
 Well No. 1 Baldwin
Blue Stem Oil Co. Company

Contractor _____

NORTH

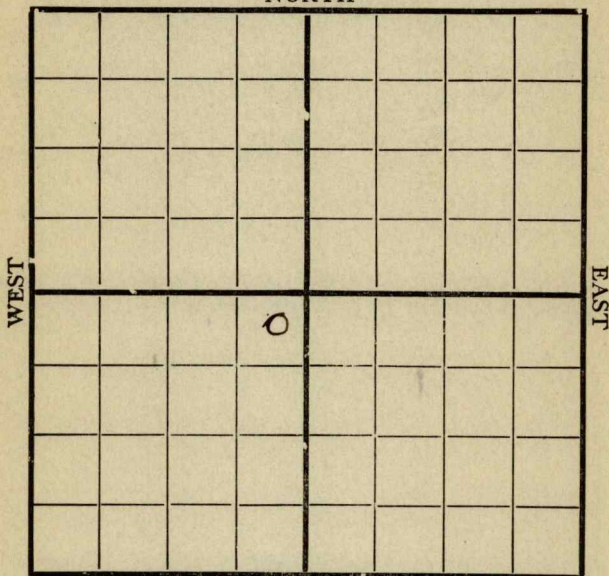

200 N-E SOUTH

Location _____

Rig up _____

Drilling and Remarks:

S. O. Co.
1205'

RECORD

Cased _____ in., _____ ft.

Sand _____

Gas _____

Oil _____

Total Depth _____

PRODUCTION

1st 24 hrs. Nat. _____

1st 24 hrs. after shot _____

Gas _____ Cu. Ft.

Dry Hole _____

Abandoned _____

Date

3/29 1919

Pyle

Scout


Map No. K10 Sec. 12 Twp. 27 R. 8Well No. 1 BaldwinBlue Stem Oil Company

Contractor _____

NORTH

WEST

EAST

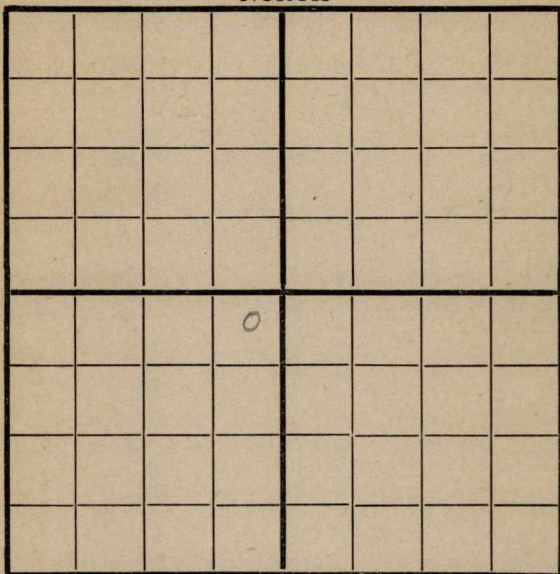

SOUTH

200 N-E

Location _____

Rig up _____

Drilling and Remarks:

D. 10 @
120.5'

RECORD

Cased _____ in., _____ ft.

Sand _____

Gas _____

Oil _____

Total Depth _____

PRODUCTION

1st 24 hrs. Nat. _____

1st 24 hrs. after shot _____

Gas _____ Cu. Ft.

Dry Hole _____

Abandoned _____

Date

4/4

1919

Pyle

Scout

Map No. *K 10* Sec. *12* Twp. *27* R. *8*Well No. *1* *Baldwin*
Blue Stem O & G. Company

Contractor

NORTH

			0				

SOUTH

200 N-E

WEST

EAST

Location _____

Rig up _____

Drilling and Remarks:

D. O. @ 1205

RECORD

Cased _____ in., _____ ft.

Sand _____

Gas _____

Oil _____

Total Depth _____

PRODUCTION

1st 24 hrs. Nat. _____

1st 24 hrs. after shot _____

Gas _____ Cu. Ft.

Dry Hole _____


Abandoned _____

Date

*4/11*191*9***Pyle**

Scout

Map No. K10 Sec. 12 Twp. 27 R. 8
 Well No. 1 Baldwin
Blue Stem Oil Company
 Contractor

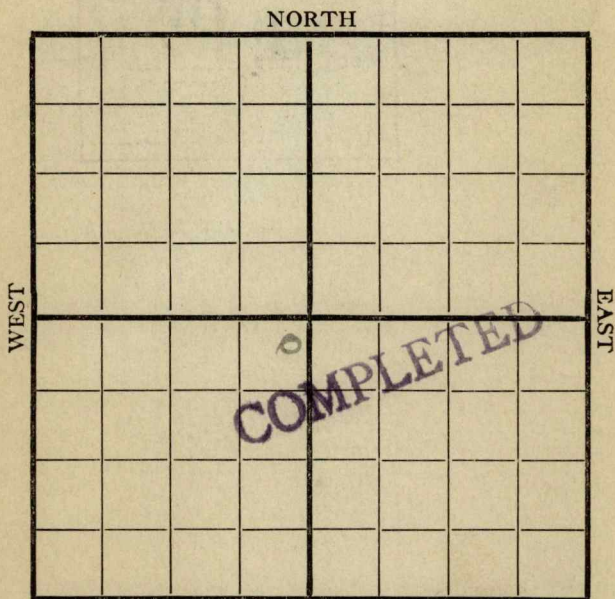

200 N-E

Location _____

Rig up _____

Drilling and Remarks:

RECORD

Cased _____ in., _____ ft.

Sand _____

Gas _____

Oil _____

Total Depth _____

PRODUCTION

1st 24 hrs. Nat. _____

1st 24 hrs. after shot _____

Gas _____ Cu. Ft.

Dry Hole 1205

Abandoned _____

Date

4/18

1919

Cyde Scout