


Map No. Kansas Sec. 25 Twp. 31 R. 2 E
Well No. 1 Van Sickle Farm
Royana Oil Corp company

NORTH

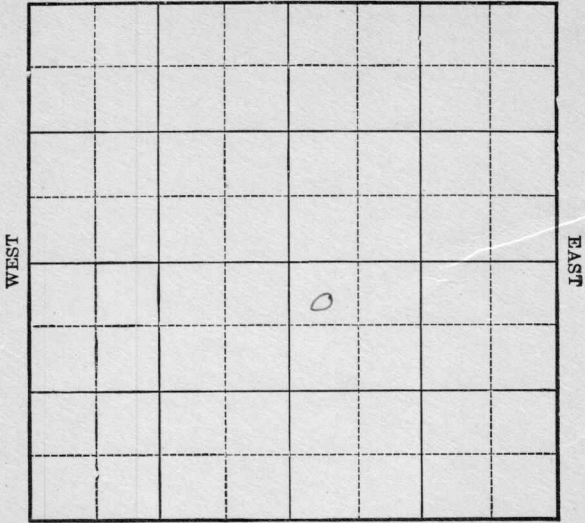

SOUTH

Location _____

Drilling Remarks _____

Rig Up _____

Drilling Remarks _____

RECORD

Cased _____ in. _____ ft.

Sand _____

Gas _____

Oil _____

Total Depth _____

PRODUCTION

1st 24 hrs. Nat. _____

1st 24 hrs. after shot _____

Gas _____ cu. ft.

Dry Hole _____

Abandoned _____

Summer

Map No. *K1* KANSAS Sec. *25* Twp. *31* R. *2* ^E

Well No. *1 Vandicik*

Boxing Jet Corp Company

Contractor

FIRST REPORTS

SECTION PLAT

330 Ft. from N. Line

Ft. from S. Line

Ft. from E. Line

330 Ft. from W. Line

		<i>0</i>	

Location

Rig up

Drilling and Remarks:

Roll

RECORD

Cased _____ in., _____ ft.

Sand _____

Gas _____

Oil _____

Total Depth _____

PRODUCTION

1st 24 hrs. Nat. _____

1st 24 hrs. after shot _____

Gas _____ Cu. Ft.

Dry Hole _____

Abandoned _____

Date

JUL 9 1926

CHAS. L. SHERWOOD

Map No. KANSAS Sec. 25 Twp. 21 R. 2E

Well No. 1 Van Sickle

Roxana Pet. Corp. Company

Contractor

SECTION PLAT

330 Ft. from N. Line

----- Ft. from S. Line

----- Ft. from E. Line

330 Ft. from W. Line

		/ 0	

FIRST REPORTS

Location -----

Rig up -----

Drilling and Remarks:

R. O. G.

RECORD

Cased ----- in., ----- ft.

Sand -----

Gas -----

Oil -----

Total Depth -----

PRODUCTION

1st 24 hrs. Nat. -----

1st 24 hrs. after shot -----

Gas ----- Cu. Ft.

Dry Hole -----

Abandoned -----

Date

JUL 14 1926

192

S. J. LEWIS

Scout

Map No. **KANSAS** Sec. 25 Twp. 21 R. 2E

Well No. 1 Van Sickle

Roxana Pet Corp Company

Contractor

SECTION PLAT

		0	

330 Ft. from N. Line

----- Ft. from S. Line

----- Ft. from E. Line

330 Ft. from W. Line

COMPLETED

Location -----

Rig up -----

Drilling and Remarks:

1842 Show gas
1877-79 " "
1879 & 1885 oil
1885 TD Swatted
220 & 22 hrs.
Shot 40 gals 1870 &
1885 Swatted

RECORD

Cased ----- in., ----- ft.

Sand -----

Gas -----

Oil -----

Total Depth -----

PRODUCTION

1st 24 hrs. Nat. -----

1st 24 hrs. after shot -----

Gas ----- Cu. Ft.

Dry Hole -----

Abandoned -----

762 & 13 hrs.

Date

AUG 11 1926

S. J. LEWIS

Scout