
Form 51—5M—3-26—22544 Sumner

Map No. TAN Sec. 25 Twp. 31 R. 2E

Well No. 2 Van Sickle Farm

Royana Pet Corp Company

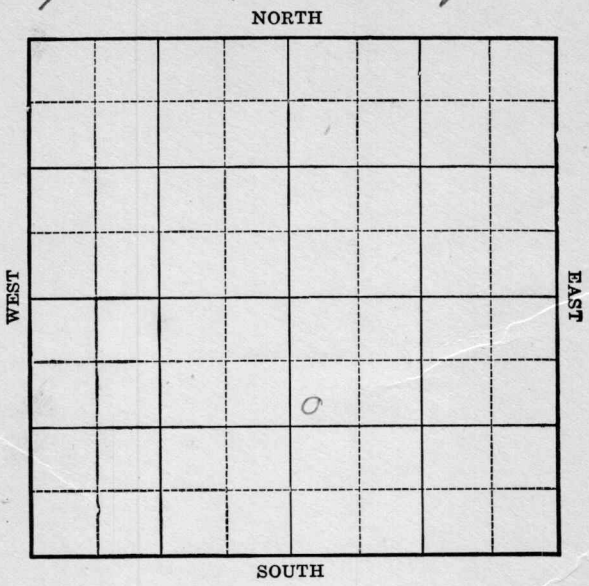

Location

Drilling Remarks

Rig Up

Drilling Remarks

RECORD

Cased in. ft.

Sand

Gas

Oil

Total Depth

PRODUCTION

1st 24 hrs. Nat.

1st 24 hrs. after shot

Gas cu. ft.

Dry Hole

Abandoned

Form 252A—5M—11-25—20913

Summerse

Map No. 11 N Sec. 25 Twp. 31 R 4 E

Well No. 2 Vansickle Farm


Rowana Pet Corp. Company

1100 Ft. from N. Line

..... Ft. from S. Line

..... Ft. from E. Line

220 Ft. from W. Line

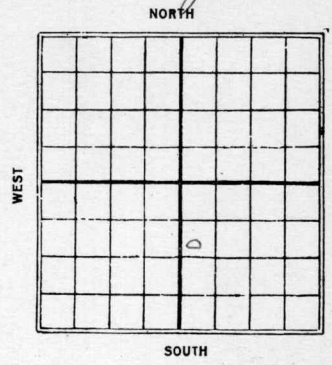

1926

Date	REPORT
8/25	Rig.
9/1	Dlg 350
9/8	" 915
9/15	" 1596
9/22	Sand shale 1822-54 Pay 1854-1884, flowed 198 bbls 1st 5 hr. Swabbed 770 bbls in 24 hrs.
9/29	Sand 1822 — Oil 1854 I.P. 1885, 198 bbls flowed 5 hrs. 770 bbls swabbed next 24 hours. shot 60 qts / 1500 bbls 1st 24 hrs. sand 1852-1885'

Form 26—1M Bks.—3-23—11959.

Farmer


Map No. KANSAS Sec. 25 Twp. 21 R. 21 E.

Well No. 2 Van Sickle

Roxana Pet Corp. Company

---------- Contractor

SECTION PLAT

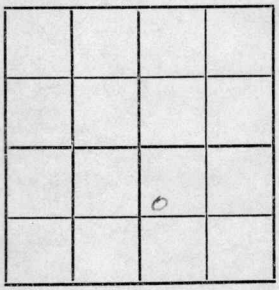

1100 Ft. from N. Line

-------- Ft. from S. Line

-------- Ft. from E. Line

220 Ft. from W. Line

FIRST REPORTS

Location ----------

Rig up ----------

Drilling and Remarks:

Rig

RECORD

Cased -------- in., ------- ft.

Sand ----------

Gas ----------

Oil ----------

Total Depth ----------

PRODUCTION

1st 24 hrs. Nat. ----------

1st 24 hrs. after shot -------

Gas ---------- Cu. Ft.

Dry Hole ----------

Abandoned ----------

Date

AUG 25 1926 192---

S. J. LEWIS Scout

Form 26—1M Bks.—3-23—11959

Sanchez

Map No. 1 KANSAS Sec. 25 Twp. 31 R. 2E


Well No. 2 Von Sickle

Roxana Pet. Company

Contractor

Correct Range from 3E to 2E

SECTION PLAT

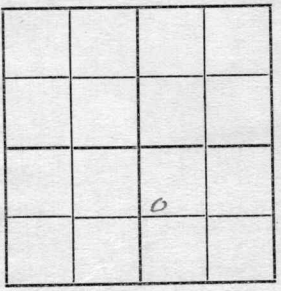

1100 Ft. from N. Line

Ft. from S. Line

Ft. from E. Line

220 Ft. from W. Line

Correction

Location

Rig up

Drilling and Remarks:

This location is in 25-31-2E and not 25-31-3E

RECORD

Cased in., ft.

Sand

Gas

Oil

Total Depth

PRODUCTION

1st 24 hrs. Nat.

1st 24 hrs. after shot

Gas Cu. Ft.

Dry Hole

Abandoned

Date SEP 8 1926 192

S. J. LEWIS Scout

Form 26—1M Bks.—3-23—11959.

Sumner


Map No. 1 KANSAS Sec. 25 Twp. 31 R. 2 E

Well No. 2 Van Sickle

Roxana Pet. & Dev. Co. Company

Contractor

SECTION PLAT

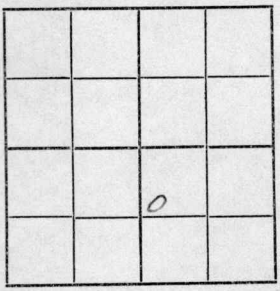

1100 Ft. from N. Line

Ft. from S. Line

Ft. from E. Line

220 Ft. from W. Line

COMPLETED

Location

Rig up

Drilling and Remarks:

Sand 1822.
Oil 1854
TD 1885
1988 hr 40 Bailed 5 hrs
770 " Swabbed
new 24 hrs
Shut

RECORD

Cased in., ft.

Sand

Gas

Oil

Total Depth

PRODUCTION

1st 24 hrs. Nat.

1st 24 hrs. after shot

Gas Cu. Ft.

Dry Hole

Abandoned

Date SEP 29 1926

SEP 29 1926 192

S. J. LEWIS Scout

abst 609 ts 1852 & 1885
1500 88 ts. / 28 24 lus.

Returned
Cards
Tracing B
France Map
Scarborough Map
Moody Map
Scarborough Plat Book
Moody Plat Book