


Summer
 Map No. Kans Sec. 25 Twp. 31 R. 2E
 Well No. 3 Van Sickle Farm
Roxana Pet Corp Company

NORTH

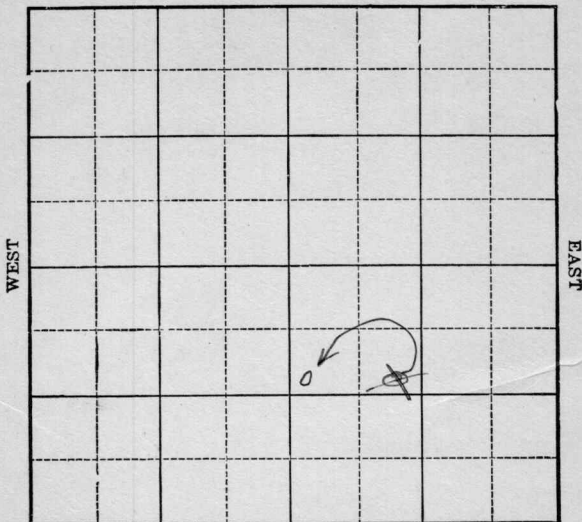

SOUTH

Location _____

Drilling Remarks _____

Rig Up _____

Drilling Remarks _____

RECORD

Cased _____ in. _____ ft.

Sand _____

Gas _____

Oil _____

Total Depth _____

PRODUCTION

1st 24 hrs. Nat. _____

1st 24 hrs. after shot _____

Gas _____ cu. ft.

Dry Hole _____

Abandoned _____


Sumner
 Map No. Kans. Sec. 25 Twp. 31 R 2 E
 Well No. 3 Kans. Sickle Farm
Roxana Pet. Company

1100
~~1120~~ Ft. from N. Line

_____ Ft. from S. Line

_____ Ft. from E. Line

640
~~990~~ Ft. from W. Line

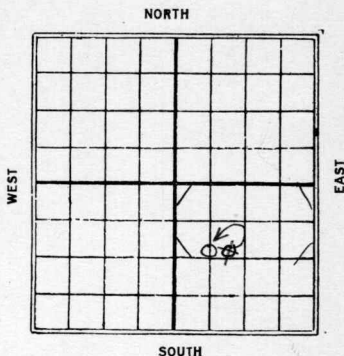

1926

Date

REPORT

10/6 Location
 10/13 rigging up
 10/20 Spud
 10/27 Drilg 875'
 11/3 " 1600'
 11/10 T.S. 1849 Oil 1883 T.D. 1890
 swabbed 87 bbls
 11/17 T.S. 1849, Oil 1883
 T.D. 1895 87 bbls nat.
 shot 40 gts / 451 bbls.
 1876-1895'

Map No. **KANSAS** Sec. *25* Twp. *31* R. *2E*Well No. *3 Van Sickle**Roxana Prod Corp.* Company

Contractor

SECTION PLAT

1120 Ft. from N. Line

Ft. from S. Line

Ft. from E. Line

990 Ft. from W. Line

FIRST REPORTS

Location

Rig up

Drilling and Remarks:

Location.

RECORD

Cased _____ in., _____ ft.

Sand _____

Gas _____

Oil _____

Total Depth _____

PRODUCTION

1st 24 hrs. Nat. _____

1st 24 hrs. after shot _____

Gas _____ Cu. Ft.

Dry Hole _____

Abandoned _____

Date

OCT 6 1926

S. J. LEWIS

Scout

Map No. KANSAS Sec. 25 Twp. 31 R. 2EWell No. 3 Van DinkleRoxana Pet. Company


Contractor

SECTION PLAT

1100 Ft. from N. Line

_____ Ft. from S. Line

_____ Ft. from E. Line

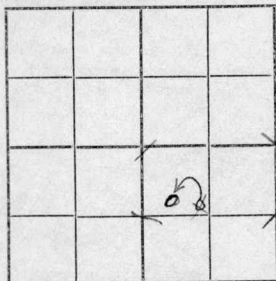640 Ft. from W. LineCorrection

Location _____

Rig up _____

Drilling and Remarks:

Reported
1100 from N. L. &
990 from W. L.

RECORD

Cased _____ in., _____ ft.

Sand _____

Gas _____

Oil _____

Total Depth _____

PRODUCTION

1st 24 hrs. Nat. _____

1st 24 hrs. after shot. _____

Gas _____ Cu. Ft.

Dry Hole _____

Abandoned _____

Date

OCT 13 1926

S. J. LEWIS

Scout

Map No. KANSAS Sec. 25 Twp. 81 R. 2EWell No. 3 Van SickleRoxana P. & Co. Company


Contractor

SECTION PLAT

1100 Ft. from N. Line

Ft. from S. Line

Ft. from E. Line

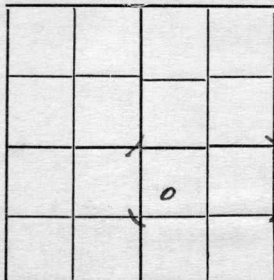640 Ft. from W. Line

COMPLETED

Location

Rig up

Drilling and Remarks:


RECORD

Cased _____ in., _____ ft.

Sand _____

Gas _____

Oil _____

Total Depth _____

PRODUCTION

1st 24 hrs. Nat. _____

1st 24 hrs. after shot _____

Gas _____ Cu. Ft.

Dry Hole _____

Abandoned _____

Date

NOV 17 1926

S. J. LEWIS

Scout