

KANSAS

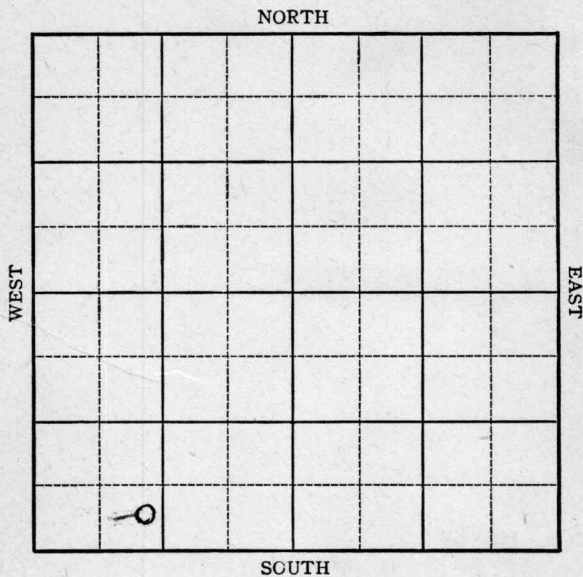
FORM 51 5M 11-44 PETROL

Summer County

Section 25 Township 31 Range 2E

Well No. #6 Sleigh

Company Shell



KANSAS

Summer County

Sec. 25 Twp. 31 R. 2EWell No. #6 Sleigh Farm

Shell Company

Miscellaneous

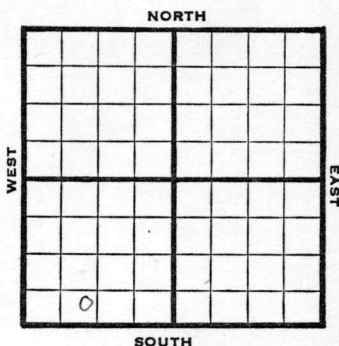
Ft. from N. Line

450 Ft. from S. Line

Ft. from E. Line

1075 Ft. from W. Line

SE SW SW

1946 1161 Elev. REPORT

6/26 Location

7/3 8" @ 152
Drlg 1857'7/9 KC 2194'
Arb 2648
4" @ 2650'
TD 2651 RUST7/16 TD 2659
3000 acid
Swb 11 oil in 2 hrs.

7/23 Pump 75 oil plus 10 W in 24 hrs

7/30 " " "

8/7 Arb. 2648
5" @ 2650
TD 2659
2000 acid.
Pump 28 oil plus 32 W. Pot.
Grav. 36.0

COMPLETED

KANSASKansas Pool Name MiscellaneousMap No. 1 Sec. 25 Twp. 31 R. 2EWell No. 6 SleighShell

Company

FIRST REPORT

Contractor

SE SW SW

SECTION PLAT

Ft. from N. Line

450

Ft. from S. Line

Ft. from E. Line

1075

Ft. from W. Line

Sumner County**RECORD**Location X

Cased _____ in., _____ ft.

Sand _____

Gas _____

Oil _____

Total Depth _____

PRODUCTION

1st 24 hrs. Nat. _____

1st 24 hrs. after shot _____

Gas _____ Cu. Ft.

Dry Hole _____

Abandoned _____

Drilling and Remarks:

Date

JUN 26 1946 19S. J. LEWIS

Scout

Pool Name Miscellaneous

KANSAS

Kansas

Map No. 1 Sec. 25 Twp. 31 R. 2EWell No. 6 Sleigh

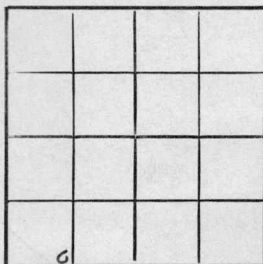
Shell

Company

COMPLETED

Contractor

SE SW SW

E 1/1161
SECTION PLAT

Ft. from N. Line

450 Ft. from S. Line

Ft. from E. Line

1075 Ft. from W. Line

Sumner County

RECORD

Location

Cased _____ in., _____ ft.

Rig up

Sand _____

Drilling and Remarks:

Gas _____

Oil _____

Total Depth 2658

PRODUCTION

1st 24 hrs. Nat. _____

1st 24 hrs. after shot _____

Gas _____ Cu. Ft.

Dry Hole _____

Abandoned _____

Date

AUG 7 1946 19

S. J. LEWIS Scout

Ar Y2648
5" O2658
20000 acioe
Pump 28000 + 3200
PT
36 2/3