


Form 51-5M-4-27-27423

Map No. _____ Sec. 25 Twp. 31 R. 2 E
Well No. 7 - Miles Farm _____
Roxana Fuel Co Company _____

NORTH

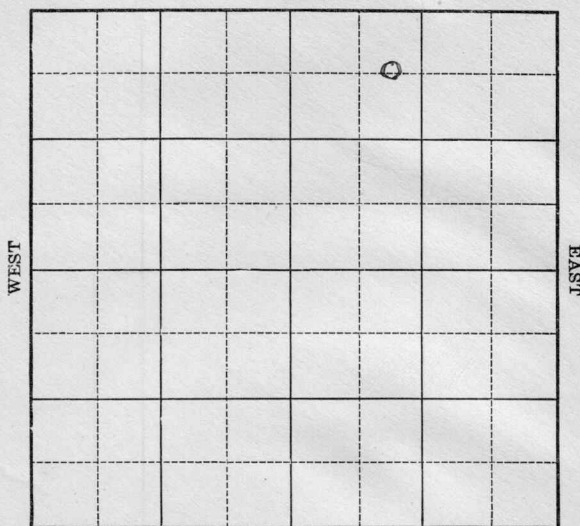

SOUTH

Location_____

Drilling Remarks

Rig Up

Drilling Remarks

RECORD

Cased _____ in. _____ ft.

Sand

Gas

Oil

Total Depth.....

PRODUCTION

1st 24 hrs. Nat. _____

1st 24 hrs. after shot-----

Gas _____ cu. ft.

Dry Hole-----

Abandoned -----

Map No. KANSAS Sec. 25 Twp. 31 R. 2 E


Well No. 7 - Miles Farm
Roxana Petr Company

653 Ft. from N. Line

..... Ft. from S. Line

..... Ft. from E. Line

999 Ft. from W. Line

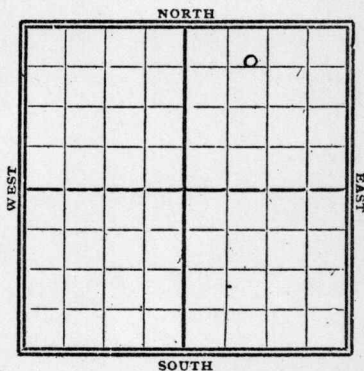

1928

Date

REPORT

8/22	Rig Bldg.
9/5	Drillg 445'
9/12	" 1085'
9/19	" 1575'
9/26	" 1750'
10/3	" 1855'
10/10	T.S. 1851' T.D. 1899'
	3 1/2 bbls oil
	1 " water
	Using this hole to pump gas into pool Sump.

MAP No. KANSAS SEC. 25 TWP. 31 R. 2E

WELL No. 7 Miles

Roxana Pet. Corp. COMPANY

CONTRACTOR

SECTION PLAT

		0	

6.53 FT. FROM N. LINE

FT. FROM S. LINE

FT. FROM E. LINE

999 FT. FROM W. LINE

FIRST REPORTS

LOCATION

RIG UP

DRILLING AND REMARKS:

Rig Building

RECORD

CASED IN. FT.

SAND

GAS

OIL

TOTAL DEPTH

PRODUCTION

1ST 24 HRS. NAT.

1ST 24 HRS. AFTER SHOT

GAS CU. FT.

DRY HOLE

ABANDONED

DATE

AUG 22 1928

S. J. LEWIS

SCOUT

MAP No. KANSAS SEC. 25 TWP. 81 R. 25

WELL No. 7 Miles

Roxana P. & Corp. COMPANY

CONTRACTOR

SECTION PLAT

		0	

653 FT. FROM N. LINE

FT. FROM S. LINE

FT. FROM E. LINE

999 FT. FROM W. LINE

COMPLETED

RECORD

LOCATION _____

CASED _____ IN. _____ FT.

RIG UP _____

SAND _____

DRILLING AND REMARKS:

GAS _____

OIL _____

TOTAL DEPTH _____

PRODUCTION

1ST 24 HRS. NAT. _____

1ST 24 HRS. AFTER SHOT _____

GAS _____ CU. FT.

DRY HOLE _____

ABANDONED _____

DATE

OCT 10 1928

S. J. LEWIS

192

SCOUT

T.D. 1851

T.D. 1899

3 1/2" oil 188" water

using this hole &

pull gas in &

flush