

Butler

Map No.

Sec

Twp

R

Well No.

Farm

Company

NORTH

WEST

EAST

SOUTH

Location

Drilling Remarks

Rig Up.

Drilling Remarks

RECORD

Cased.....in.ft.

Sand

Gas

Oil

Total Depth

PRODUCTION

1st 24 hrs. Nat.

1st 24 hrs. after shot

Gas..... cu. ft.

Dry Hole

Abandoned


Butler

Map No. K5 Sec. 23 Twp. 27 R. 7Well No. 3-Barnhill Farm
Phillips Pet Company330 Ft. from N. Line

_____ Ft. from S. Line

330 Ft. from E. Line

_____ Ft. from W. Line

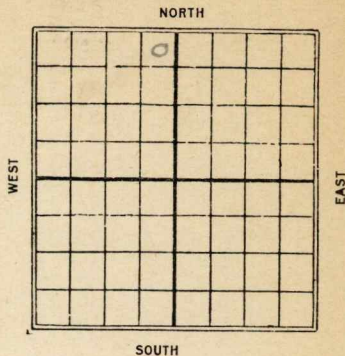

1926

Date

REPORT

12/22 Bldg Rig

12/30 Rig

1927

1/6 Rigging up

1/13 Dredg 740

1/19 " 1140

1/26 " 1390

2/3 " 1900

2/10 " 2610

2/16 sand 2621-2677

180/447 bbls

I.D. 2677

Map No. ¹⁰ **KANSAS** Sec. ²³ Twp. ²⁷ R. ⁷
 Well No. ³ *Barn his*
Phillips pet Co. Company

Contractor

FIRST REPORTS**SECTION PLAT***330*


Ft. from N. Line

Ft. from S. Line

330

Ft. from E. Line

Ft. from W. Line

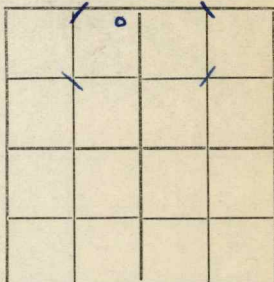

Location -----

Rig up -----

Drilling and Remarks:

*Blow rig***RECORD**

Cased ----- in., ----- ft.

Sand -----

Gas -----

Oil -----

Total Depth -----

PRODUCTION

1st 24 hrs. Nat. -----

1st 24 hrs. after shot -----

Gas ----- Cu. Ft.

Dry Hole -----

Abandoned -----

Date

DEC 22 1926

192

CHAS. L. SHERWOOD

Scout

Butler

 10 KANSAS 23 Twp. 27 R. 7
 Map No. Sec. Twp. R.

 Well No. 3 Bankhill
 Phillips pet Co Company

Contractor

COMPLETED

SECTION PLAT

330 Ft. from N. Line

Ft. from S. Line

330 Ft. from E. Line

Ft. from W. Line

Location

Rig up

Drilling and Remarks:

1807 447 bls.

RECORD

Cased in. ft.

Sand 2671-2677

Gas

Oil

Total Depth 2677

PRODUCTION

1st 24 hrs. Nat.

1st 24 hrs. after shot

Gas Cu. Ft.

Dry Hole

Abandoned

Date

FEB 16 1927

CHAS. L. SHERWOOD

192

Scout