

Barton

KANSAS

Sec. 18 Twp. 20 R. 12W

Well No. #1 Batchman Farm

C. U. Bay Company

Sunny Valley


330' Ft. from N. Line

_____ Ft. from S. Line

_____ Ft. from E. Line

330' Ft. from W. Line

NW NE

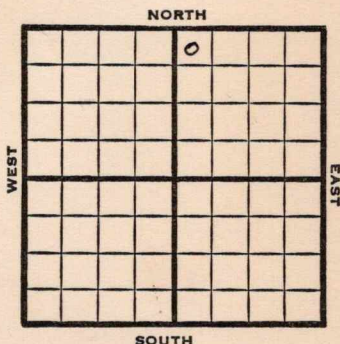

1949

Elev 1850'

REPORT

2/16

RUR

2/23

8" @ 360'
Drlg. 2905'

3/2

Lansing 3171'
Arbuckle 3418'

TD 3422'
5" @ 3419'

3/8

24 shots 3194-99'
24 shots 3204-08
1000 acid
Swb 20 bbls oil PH 2 hrs.

3/16

"

3/22

"

3/30

"

4/6

"

4/12

"

4/20

"

4/27

TD 3419'
Arb. 3418'
Lans. 3171'
5" @ 3419'
Perf Lans.
1000 acid
Pump 190 Oil Pot
39° Br.
Comp

COMPLETED

Map No. _____ Sec. 18 Twp. _____ R. _____

Well No. 1 Batchman

C. U. Bay Company

FIRST REPORT Contractor

NW NE


SECTION PLAT

330 Ft. from N. Line

_____ Ft. from S. Line

_____ Ft. from E. Line

330 Ft. from W. Line

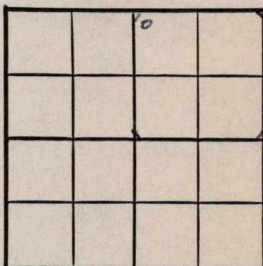

Barton County

Location _____

Rig up _____

Drilling and Remarks:

R U R

RECORD

Cased _____ in., _____ ft.

Sand _____

Gas _____

Oil _____

Total Depth _____

PRODUCTION

1st 24 hrs. Nat. _____

1st 24 hrs. after shot _____

Gas _____ Cu. Ft.

Dry Hole _____

Abandoned _____

Date

FEB 16 1949 19

S. J. LEWIS Scout

Map No. K46 ^{Kansas} Sec. 18 Twp. 20 R. 12W

Well No. 1 Batchman

C. U. Bay Company

COMPLETE Contractor

NW NE

F. 11838
SECTION PLAT

330 Ft. from N. Line

_____ Ft. from S. Line

_____ Ft. from E. Line

330 Ft. from W. Line

		0	

Barton County

Location _____

Rig up _____

Drilling and Remarks:

Core 3418
Liana 3171
AD 3419
Perf 4 ans
1000 acid
Perf 190 oil
89-5-44

RECORD

Cased _____ in., _____ ft.

Sand _____

Gas _____

Oil _____

Total Depth 5'03419

PRODUCTION

1st 24 hrs. Nat. _____

1st 24 hrs. after shot _____

Gas _____ Cu. Ft.

Dry Hole _____

Abandoned _____

Date

APR 27 1949 19

S. J. LEWIS Scout