


Map No. Kansas Sec. 22 Twp. 27 R. 7Well No. 4 - Barnhill FarmSinclair Oil Company

NORTH

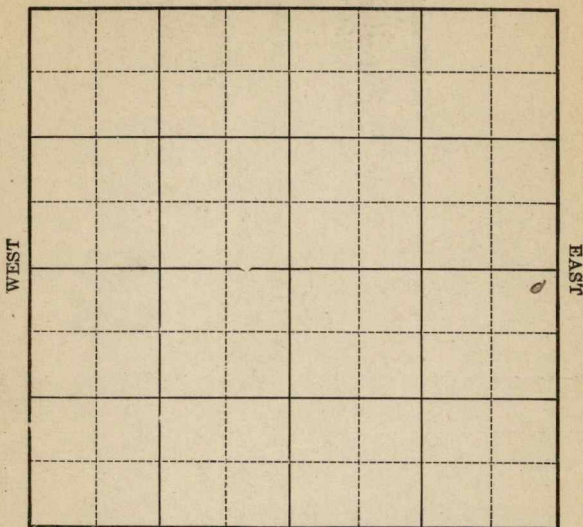

SOUTH

Location _____

Drilling Remarks _____

Rig Up _____

Drilling Remarks _____

RECORD

Cased _____ in. _____ ft.

Sand _____

Gas _____

Oil _____

Total Depth _____

PRODUCTION

1st 24 hrs. Nat. _____

1st 24 hrs. after shot _____

Gas _____ cu. ft.

Dry Hole _____

Abandoned _____

Butler

Map No.

Kansas

Sec.

22

Twp.

27

R.

7

Well No.

4 Barnsdall

Farm

Sinclair O. & G.


Company

330 Ft. from N. Line

Ft. from S. Line

330 Ft. from E. Line

Ft. from W. Line

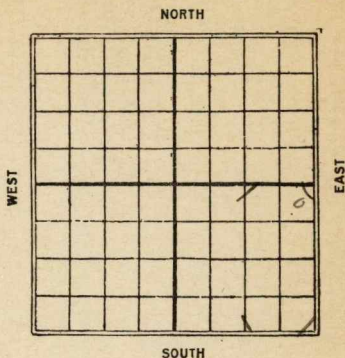

Date

REPORT

1926

3/31

Location

4/7

Bldg Rig.

4/14

Rig

4/21

Rig

4/30

Spudding.

5/8

Dlg 1150'

5/12

" 1490'

5/19

" 2150'

6/5

Sand 2683-2741

200 g to 300 lbs

Butter

110 KANSAS

Map No.

Sec.

22

Twp.

27

R.

7

Well No.

*4, Butcher
Inclair Oil & Gas Co.*

Company

Contractor

FIRST REPORTS

SECTION PLAT

330

Ft. from N. Line

Ft. from S. Line

330

Ft. from E. Line

Ft. from W. Line

			<i>/</i>
			<i>o</i>

Location

RECORD

Cased _____ in., _____ ft.

Sand _____

Gas _____

Oil _____

Total Depth _____

PRODUCTION

1st 24 hrs. Nat. _____

1st 24 hrs. after shot _____

Gas _____ Cu. Ft.

Dry Hole _____

Abandoned _____

Date

MAR 31 1926

CHAS. L. SHERWOOD

192

Scout

K10 KANSAS

Map No. _____ Sec. *22* Twp. *27* R. *7*Well No. *4* *Burn hill**Sinclair* *Oil & Co* Company

Contractor

COMPLETED

SECTION PLAT

330

_____ Ft. from N. Line

_____ Ft. from S. Line

330

_____ Ft. from E. Line

_____ Ft. from W. Line

			<i>o</i>

Location _____

Rig up _____

Drilling and Remarks:

200 / 300 Bbl.

RECORD

Cased _____ in., _____ ft.

Sand *2683-2741*

Gas _____

Oil _____

Total Depth *2741*

PRODUCTION

1st 24 hrs. Nat. _____

1st 24 hrs. after shot _____

Gas _____ Cu. Ft.

Dry Hole _____

Abandoned _____

Date

JUN 2 1926

CHAS. L. SHERWOOD

192

Scout