


DX 78-1 Sumner

KANSAS

Section 34 Township 31S Range 2E

Well No. 1 Spencer

Company McNeish & Gralapp

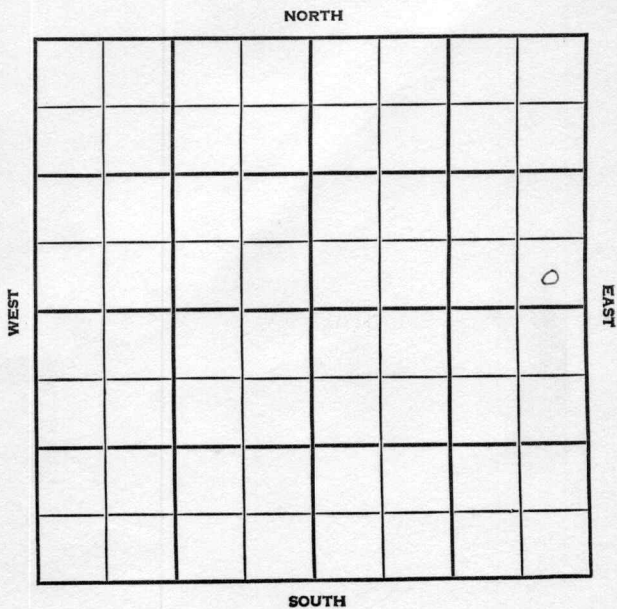

Sumner County

KANSAS

SEC.

34

TWP.

31S

R.

2E

WELL NO.

1 Spencer

FARM

COMPANY

McNeish & Gralapp

CONTRACTOR


Wildcat

Ft. from N. Line

Ft. from S. Line

Ft. from E. Line

Ft. from W. Line

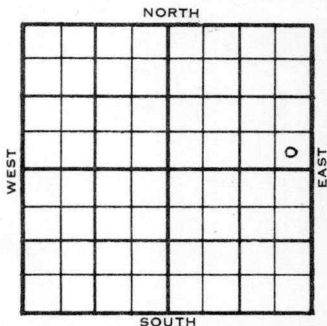

SE SE NE

ELEVATION

REPORT

1955

5/25

Stal 2315;  
TD 2345; 8" 86  
D&A

**FIRST REPORT**

*g*

**ABANDONED**

