


Summer

Map No. *As* Sec. *25* Twp. *31* R. *2E*

Well No. *1 - C.S. Wiles* Farm
Rotana Petr. Company

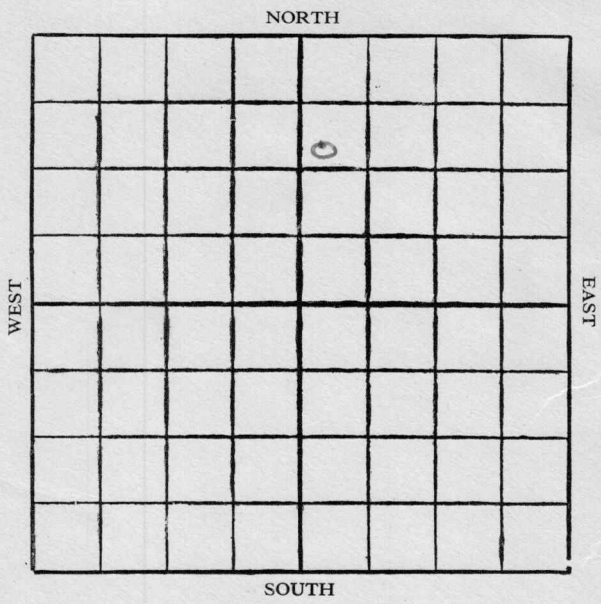

Location

Drilling Remarks

.....

.....

Rig Up

Drilling Remarks

.....

.....

RECORD

Cased in. ft.

Sand

Gas

Oil

Total Depth

PRODUCTION

1st 24 hrs. Nat.

1st 24 hrs. after shot

Gas cu. ft.

Dry Hole

Abandoned

Summer

Map No. *15* Sec. *25* Twp. *31* R. *2E*

Well No. *1-C.S. Wiles* Farm


Rotana Pet Company

1118 Ft. from N. Line

..... Ft. from S. Line

..... Ft. from E. Line

220 Ft. from W. Line

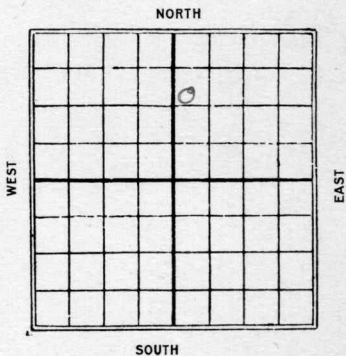

1927

Date REPORT

<i>1/5</i>	<i>Location</i>
<i>1/12</i>	<i>_____</i>
<i>1/19</i>	<i>Rig</i>
<i>1/26</i>	<i>_____</i>
<i>2/2</i>	<i>Rigging up</i>
<i>2/9</i>	<i>Drilling 535</i>
<i>2/16</i>	<i>" 1110</i>
<i>2/23</i>	<i>" 1585</i>
<i>3/2</i>	<i>Top sand 1847 oil 1883</i> <i>T.D. 1905 - 450' oil in hole</i>
<i>3/9</i>	<i>shot 60 qts 1882 - 1902</i> <i>1500' oil in hole</i>
<i>3/16</i>	<i>J.S. 1847 - oil 1883</i> <i>J.D. 1905</i> <i>shot 60 qts 1882</i> <i>to 1902 swabbed</i> <i>850 bbls 24 hrs</i>

Map No. KANSAS Sec. 25 Twp. 21 R. 2E

Well No. 1 C. S. Viles

Roxana Pet. Corp. Company

Contractor

SECTION PLAT

1118 Ft. from N. Line

----- Ft. from S. Line

----- Ft. from E. Line

220 Ft. from W. Line

		0	

FIRST REPORTS

Location ✓

Rig up -----

Drilling and Remarks:

RECORD

Cased ----- in., ----- ft.

Sand -----

Gas -----

Oil -----

Total Depth -----

PRODUCTION

1st 24 hrs. Nat. -----

1st 24 hrs. after shot -----

Gas ----- Cu. Ft.

Dry Hole -----

Abandoned -----

Date

JAN 5 1927

192

S. J. LEWIS

Scout

Map No. **KANSAS** Sec. 25 Twp. 31 R. 2E

Well No. 1 C. S. Hiles

Rotana P. & Corp. Company

Contractor

SECTION PLAT

1118 Ft. from N. Line

----- Ft. from S. Line

----- Ft. from E. Line

220 Ft. from W. Line

		0	

COMPLETED

Location -----

Rig up -----

Drilling and Remarks:

*T.B. 1847 oil 1883
VII 1905
Brod 609 to 1882
to 1902 2100 ft ed
850 88 to 24 hrs*

RECORD

Cased ----- in., ----- ft.

Sand -----

Gas -----

Oil -----

Total Depth -----

PRODUCTION

1st 24 hrs. Nat. -----

1st 24 hrs. after shot -----

Gas ----- Cu. Ft.

Dry Hole -----

Abandoned -----

Date

MAR 16 1927

192

S. J. LEWIS

Scout