


Butler.

Map No. 17N Sec. 12 Twp. 27 R. 7

Well No. 1 Cora Farm

Philips Pet Company

NORTH

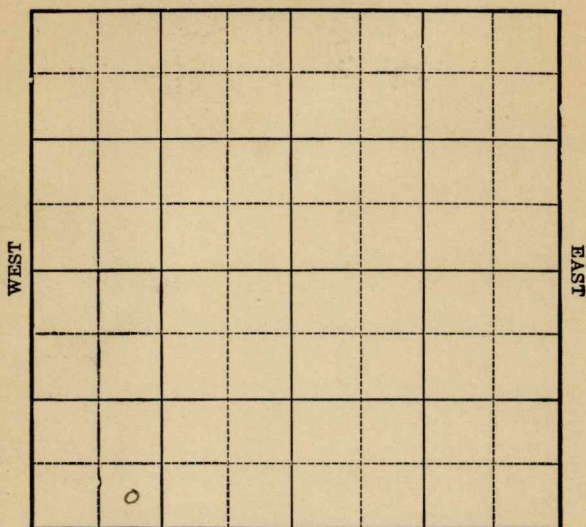

SOUTH

Location -----

Drilling Remarks

Rig Up

Drilling Remarks

RECORD

Cased_____in. _____ft.

Sand

Gas

Oil

Total Depth

PRODUCTION

1st 24 hrs. Nat.-----

1st 24 hrs. after shot_____

Gas_____cu. ft.

Dry Hole _____

Abandoned

Map No. 1 Sec. 12 Twp. 27 R. 7

Well No. 1 Cora Farm


Phillips Per Company

Ft. from N. Line

330 Ft. from S. Line

Ft. from E. Line

990 Ft. from W. Line

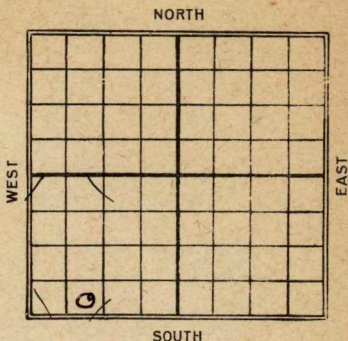

1926

Date

REPORT

9/15 Rigging up

9/22 same

9/29 Drlg 820

10/13 " 1800'

10/27 Sand 2694-2730

Oil 2704-27

120/300 bbl

Butler Co

10 KANSAS

Map No. _____ Sec. 12 Twp. 27 R. 7

Well No. 1
Phillips Let Co

Company

Contractor

FIRST REPORTS


_____ Ft. from N. Line

330 _____ Ft. from S. Line

_____ Ft. from E. Line

990 _____ Ft. from W. Line

SECTION PLAT

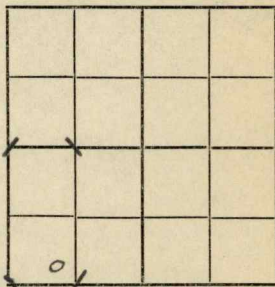

Location _____

Rig up _____

Drilling and Remarks:

Digging up

RECORD

Cased _____ in., _____ ft.

Sand _____

Gas _____

Oil _____

Total Depth _____

PRODUCTION

1st 24 hrs. Nat. _____

1st 24 hrs. after shot _____

Gas _____ Cu. Ft.

Dry Hole _____

Abandoned _____

Date

SEP 15 1926

CHAS. L. SHERWOOD

192

Scout

10 **KANSAS** 12 27 7
 Map No. Sec. Twp. R.
 Well No. 1 *Conq*
Phillip Pet Co

Company

Contractor

COMPLETED**SECTION PLAT**

Ft. from N. Line


330

Ft. from S. Line

Ft. from E. Line

990

Ft. from W. Line

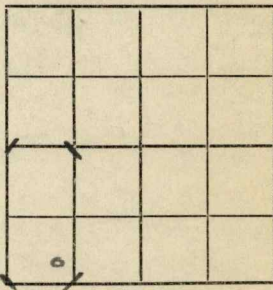

Location

Rig up

Drilling and Remarks:

ol 2704-27

RECORD

Cased _____ in. _____ ft.

Sand 2694-2730

Gas _____

Oil _____

Total Depth 2730

PRODUCTION

1st 24 hrs. Nat. _____

1st 24 hrs. after shot _____

Gas _____ Cu. Ft.

Dry Hole _____

Abandoned _____

Date

OCT 27 1926

CHAS. L. SHERWOOD

192

Scout