


Map No. KANSAS Sec. 36 Twp. 31 R. 2^E

Well No. 1 - Bowen Farm
Schartz Leal Company

NORTH

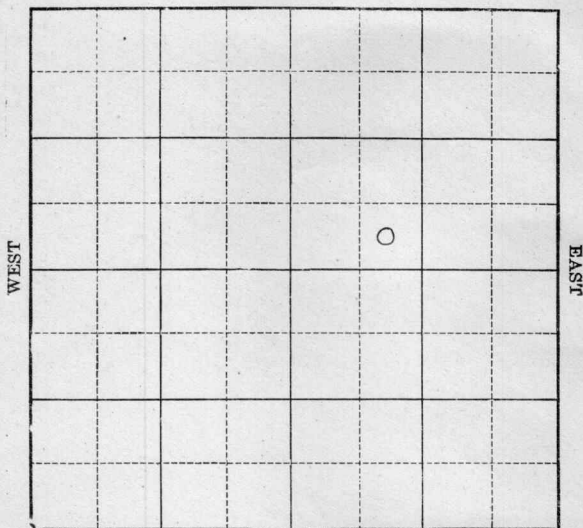

SOUTH

Location _____

Drilling Remarks _____

Rig Up _____

Drilling Remarks _____

RECORD

Cased _____ in. _____ ft.

Sand _____

Gas _____

Oil _____

Total Depth _____

PRODUCTION

1st 24 hrs. Nat. _____

1st 24 hrs. after shot _____

Gas _____ cu. ft.

Dry Hole _____

Abandoned _____

Map No. KANSAS Sec. 36 Twp. 31 R. 2^E

Well No. 1- Boyer Farm
Schertz et al Company


_____ Ft. from N. Line

250 Ft. from S. Line

_____ Ft. from E. Line

1000 Ft. from W. Line

1930

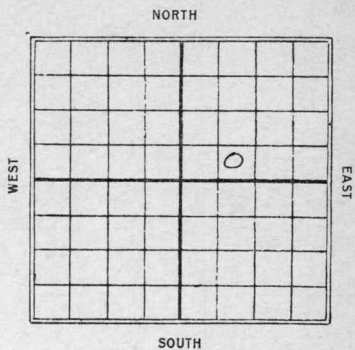

Date	REPORT
6/18	Machine
6/25	Spdg. 250'
7/2	10" - 525 Hdg. 650'
7/9	—
7/16	S.D. 1000'
7/23	U.R. 5" - 1605'
7/30	U.R. 5" - 1700'
8/6	S.D. 1800'
8/13	5" - 1700 Clog out 1800'
8/20	S.D. 1800'
8/27	—
9/3	—
9/10	—
9/17	—
9/24	Top sand 1909 show oil 1929 TD. 1933 shot 15 qt 1927-33 Dry & Abandon

Map No. **KANSAS** Sec. 36 Twp. 31 R. 2E

Well No. 1 Boyer

Schartz et al Company

Contractor

SECTION PLAT

FIRST REPORTS

_____ Ft. from N. Line

250 Ft. from S. Line

_____ Ft. from E. Line

1000 Ft. from W. Line

		0	

Location _____

Rig up _____

Drilling and Remarks:

Wack.

RECORD

Cased _____ in., _____ ft.

Sand _____

Gas _____

Oil _____

Total Depth _____

PRODUCTION

1st 24 hrs. Nat. _____

1st 24 hrs. after shot _____

Gas _____ Cu. Ft.

Dry Hole _____

Abandoned _____

Date

JUN 18 1930 **CHAS. L. SHERWOOD**

Scout

Summer

Map No. 1 **KANSAS** Sec. 36 Twp. 31 R. 2 ^E

Well No. 1 *Bayer*

Schwartz exal Company

Contractor

COMPLETE

SECTION PLAT

_____ Ft. from N. Line

750 Ft. from S. Line

_____ Ft. from E. Line

1000 Ft. from W. Line

ABANDONED

		0	

Location _____

RECORD

Rig up _____

Cased _____ in., _____ ft.

Drilling and Remarks:

Sand _____

Top Sand 1909
Show Oil 1929

Gas _____

15/1927-1933

Oil _____

Total Depth 1933

D+u

PRODUCTION

1st 24 hrs. Nat. _____

1st 24 hrs. after shot _____

Gas _____ Cu. Ft.

Dry Hole

Abandoned

Date

SEP 2 1930

CHAS. L. SHERWOOD

19

Scout