


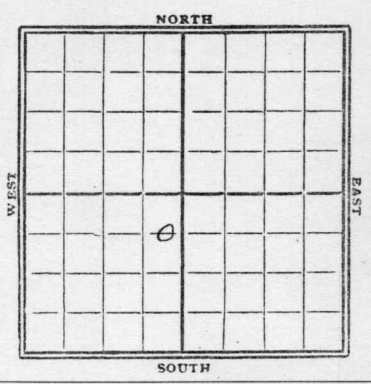

Map No. KANSAS Sec. 36 Twp. 31 R. 2<sup>E</sup>  
 Well No. 3-13 Bussard Farm  
Washoma etal Company

660 Ft. from N. Line  
 \_\_\_\_\_ Ft. from S. Line  
200 Ft. from E. Line  
 \_\_\_\_\_ Ft. from W. Line



1929

Date \_\_\_\_\_ REPORT O. W. D. D

Date	REPORT
7/10	<u>Roll</u>
7/17	—
7/24	—
7/31	—
8/17	<u>Bbly Rig</u>
8/14	<u>Rig</u>
8/21	—
8/28	<u>Rig up</u>
9/4	<u>Spdy 280'</u>
9/11	<u>drly 532'</u>
9/18	<u>" 1000'</u>
9/25	<u>sety 8"-1610'</u>
10/2	<u>sand 1957-68</u> <u>filled up 1000' fluid</u> <u>in 2 hours</u>
10/9	<u>sand 1957-68</u> <u>T.D. 1968</u> <u>200 bbls oil</u> <u>150 " water</u> <u>Pump.</u>

(OVER)

1935

O. W. D. D

4/10 Rgn

4/18 dly 2180

4/26 K @ 2300 50 6" 2305 57

5/2 S.O. 2464 S.O. 2477

dly 2555

5/9 dly 2686

5/16 Sil 2742 HFW 2769

TJ 2775 PB 2500

5/23 —

5/29 1000 acid

6/6 C.O.

6/13 50 vib per day

6/20 — 6/28 —

7/2 Silicious 2742

TJ 2775

PB 2500

1000 acid

5 Bbls.

COMPLETED

*Summer*

Map No. KANSAS Sec. 36 Twp. 31 R. 2 <sup>E</sup>

Well No. 3 "B" Bussard  
Washoma et al Company

Contractor

**FIRST REPORTS**

**SECTION PLAT**

660 Ft. from N. Line

\_\_\_\_\_ Ft. from S. Line

200 Ft. from E. Line

\_\_\_\_\_ Ft. from W. Line


Location \_\_\_\_\_

Rig up Rols

Drilling and Remarks:

**RECORD**

Cased \_\_\_\_\_ in., \_\_\_\_\_ ft.

Sand \_\_\_\_\_

Gas \_\_\_\_\_

Oil \_\_\_\_\_

Total Depth \_\_\_\_\_

**PRODUCTION**

1st 24 hrs. Nat. \_\_\_\_\_

1st 24 hrs. after shot \_\_\_\_\_

Gas \_\_\_\_\_ Cu. Ft.

Dry Hole \_\_\_\_\_

Abandoned \_\_\_\_\_

Date

7/10/29 19

**CHAS. L. SHERWOOD**

Scout

**KANSAS**

*Summer*

Map No. *1* Sec. *36* Twp. *31* R. *2* <sup>E</sup>

Well No. *3 B* *Bussard*

*Woshoma* *Coal* Company

Contractor

**COMPLETE**

*660* Ft. from N. Line

..... Ft. from S. Line

*700* Ft. from E. Line

..... Ft. from W. Line

**SECTION PLAT**


Location.....

Rig up.....

Drilling and Remarks:

*200 Bb oil*  
*150 Bb water.*

**RECORD**

Cased..... in., ..... ft.

Sand *1957-1968*

Gas.....

Oil.....

Total Depth *1968*

**PRODUCTION**

1st 24 hrs. Nat.....

1st 24 hrs. after shot.....

Gas..... Cu. Ft.

Dry Hole.....

Abandoned.....

Date

*OCT 9 1929*

**CHAS. L. SHERWOOD**

Scout

Map No. 1 Sec. 36 Twp. 31 R. 2E

Well No. 313-Bussard


Washoma etal Company

Contractor

FIRST REPORTS

SECTION PLAT

660 Ft. from N. Line  
..... Ft. from S. Line  
200 Ft. from E. Line  
..... Ft. from W. Line

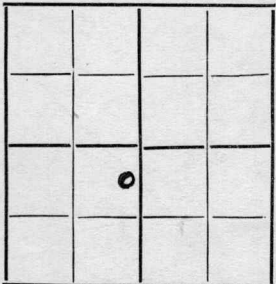

OWN

Location.....

Rig up.....

Drilling and Remarks:

OTD 1968  
Rgn to  
super  
CP1

RECORD

Cased..... in., ..... ft.  
Sand.....  
Gas.....  
Oil.....  
Total Depth.....

PRODUCTION

1st 24 hrs. Nat.....  
1st 24 hrs. after shot.....  
Gas..... Cu. Ft.  
Dry Hole.....  
Abandoned.....

Date

ORVAL MANNSCHECK

4-10-35 192.....

Scout

KANSAS

Map No. 1 Sec. 36 Twp. 31 R. 2E

Well No. 3B-Bussard

Wichita et al Company

Contractor

COMPLETED

SECTION PLAT

660 Ft. from N. Line  
..... Ft. from S. Line  
200 Ft. from E. Line  
..... Ft. from W. Line

	0		

Location.....

Rig up.....

Drilling and Remarks:

PB 2500  
1000 and  
5 bpts

RECORD

Cased..... in., ..... ft.

Sand Johnson 2742

Gas.....

Oil.....

Total Depth 2775

PRODUCTION

1st 24 hrs. Nat.....

1st 24 hrs. after shot.....

Gas..... Cu. Ft.

Dry Hole.....

Abandoned.....

Date

7-2-35 192.....

ORVAL MANSCHRECK

Scout