

5-A
50-35 MPC

Summer

Map No. KANSAS Sec. 27 Twp. 31 R. 2E

Well No. 1-Evers Farm

~~XXXXXXXXXXXXXXXXXXXX~~

Company

Haypenny et al


NORTH

Ft. from N. Line

330 Ft. from S. Line

330 Ft. from E. Line

Ft. from W. Line

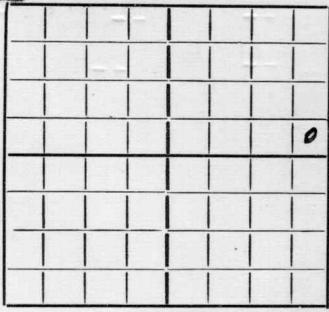

Elev. 1168

REPORT

O.W.D.D

Date	Description
1935	
12/30	Moving Mat
1/10/36	Spud S.D.
1/17	Drlg 20
1/24	S.D. 200
1/31	— 2/7 — 2/14 — 2/21 — 2/28 —
3/13	12" - 420 T.D. 456 S.D.
3/20	--
3/27	-- 4/2 -- 4/10 -- 4/16 -- 4/23 -- 4/30 --
5/7	Run 12" Cleaning out.
5/14	S.D.
5/21	-- 5/28 -- 6/4 -- 6/11 -- 6/18 -- 6/25 --
7/2	-- 7/9 -- 7/16 -- 7/23 -- 7/30 -- 8/6 --
8/13	-- 8/20 --
8/27	Skidding 25' north.
9/3	--
9/10	Spud.
9/18	Drlg. 220'.
9/24	S.D. 220'.
10/1	Drlg. 4000'.
10/8	Drlg. 508'.
10/15	Drlg. 519' shut down.

OVER

10/22-10/29--

11/6/36--Shut down 519

11/12--11/19--11/27--12/3--12/10--

12/17--12/24--12/29--

1937

1/7 Shut down 519'.

1/14 " " "

1/21 " " "

1/28 " " "

2/4 " " "

2/11 " " "

2/18 " " "

2/26 " " "

3/4 " " "

3/11 " " "

3/18 " " "

3/25 " " "

3/31 T.D. 519'.

ABANDONED

1938

O. W. D. D

4/20 Old T.D. 519'.

8" @ 1532'.

Stalnaker 1845'.

Drlg. 1900'.

4/29 SD 1930'.

5/6 Fsg. 1945'.

5/12 Drlg. 1960'.

5/20 SD 1960'.

OVER

1938

5/27 T.D. 2015'. Cementing cave.

6/3 " " " " "

6/10 " " " " "

6/17 " " " " "

6/24 " " " " "

7/1 " " " " "

7/8 " " " " "

7/13 T. D. 2030'.
Abandoned hole.
(Run out of money)

ABANDONED

1938

O. W. D. D

9/21 Old T. D. 2030'.

6" at 2030'.

K. C. 2440'.

T. D. 2440'.

3 B. W.

FIRST REPORT

and

ABANDONED

Map No. 1 Sec. 27 Twp. 31 R. 2E

Well No. 1 - Evers

W. L. Husted et al Company

Contractor

FIRST REPORTS

SECTION PLAT

..... Ft. from N. Line

330 Ft. from S. Line

330 Ft. from E. Line

..... Ft. from W. Line

			0

Location.....

Rig up.....

Drilling and Remarks:

moving mat.

RECORD

Cased..... in., ft.

Sand.....

Gas.....

Oil.....

Total Depth.....

PRODUCTION

1st 24 hrs. Nat.....

1st 24 hrs. after shot.....

Gas..... Cu. Ft.

Dry Hole.....

Abandoned.....

Date

ORVAL MANNSCHRECK

12-30-35 192.....

Scout

Map No. _____ Sec. 27 Twp. 31 R. 2E

Well No. J. W. Evers.

D. L. Husted & Co. Company

Contractor

SECTION PLAT

			0

_____ Ft. from N. Line

320 Ft. from S. Line

330 Ft. from E. Line

_____ Ft. from W. Line

ABANDONED

Location _____

Rig up _____

Drilling and Remarks:

RECORD

Cased _____ in., _____ ft.

Sand _____

Gas _____

Oil _____

Total Depth 519

PRODUCTION

1st 24 hrs. Nat. _____

1st 24 hrs. after shot _____

Gas _____ Cu. Ft.

Dry Hole _____

Abandoned

Date

MAR 31 1937

Map No. Sec. 27 Twp. 31 R. 2E

Well No. 1 Evers

Haypenny etal Company

CORRECTION Company name. Contractor

FIRST REPORT

SECTION PLAT

SE NE

 Ft. from N. Line

330 Ft. from S. Line

330 Ft. from E. Line

 Ft. from W. Line

			0

Location

Rig up

Drilling and Remarks:

OWDD OTD 519

8" 1532

Stalnaker 1845

Drlg. 1900

RECORD

Cased in., ft.

Sand

Gas

Oil

Total Depth

PRODUCTION

1st 24 hrs. Nat.

1st 24 hrs. after shot

Gas Cu. Ft.

Dry Hole

Abandoned

Date

APR 20 1938

19

H. D. Hatfield

Scout

Map No. 1 Sec. 27 Twp. 31 R. 2E

Well No. 1 Evers

Haypenny etal Company

Contractor

ABANDONED

SE NE

 Ft. from N. Line

330 Ft. from S. Line

330 Ft. from E. Line

 Ft. from W. Line

SECTION PLAT

			0

Location

Rig up

Drilling and Remarks:

abd hole

(Run out of money)

RECORD

Cased in., ft.

Sand

Gas

Oil

Total Depth 2030

PRODUCTION

1st 24 hrs. Nat.

1st 24 hrs. after shot

Gas Cu. Ft.

Dry Hole

Abandoned

Date

JUL 13 1938 19

H. D. Hatfield Scout

Summer

Map No. Sec. 27 Twp. 31 R. 2E

Well No. 1 Evers

Haypenny etal Company

FIRST REPORT . Contractor

♀
COMPLETED
SE NE

SECTION PLAT

			o

 Ft. from N. Line

330 Ft. from S. Line

330 Ft. from E. Line

 Ft. from W. Line

ABANDONED

O. W. D. D.

Location

RECORD

Cased in., ft.

Rig up

Sand

Drilling and Remarks:

Gas

OWDD-OTD 2030

Oil

6" - 2030

Total Depth

K.C. 2440 TD

PRODUCTION

3 BW

1st 24 hrs. Nat.

D & A

1st 24 hrs. after shot

Gas Cu. Ft.

Dry Hole

Abandoned

Date

SEP 21 1938

19

H. D. Hatfield Scout