


Map No. KANSAS Sec. 36 Twp. 31 R. 2E
Well No. 1-C Brussard Farm
Washoma Leal Company

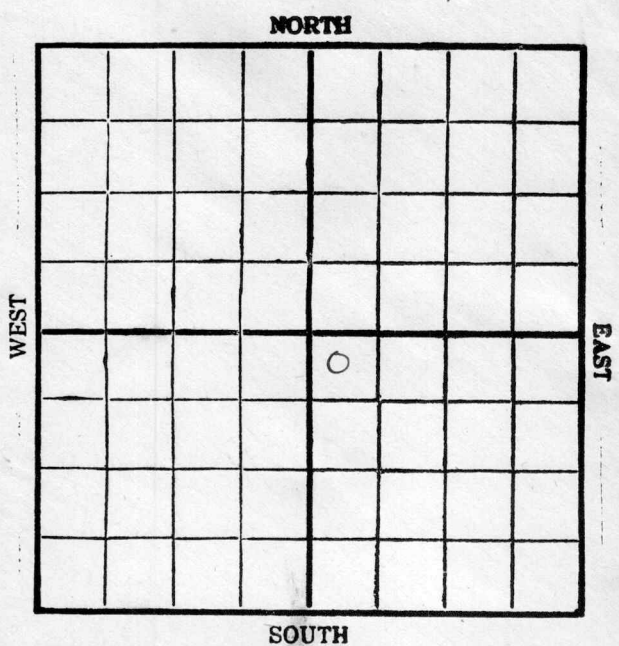

Location _____
Drilling Remarks _____

Rig Up _____
Drilling Remarks _____

RECORD

Cased _____ in. _____ ft.
Sand _____
Gas _____
Oil _____
Total Depth _____

PRODUCTION

1st 24 hrs. Nat. _____
1st 24 hrs. after shot _____
Gas _____ cu. ft. _____
Dry Hole _____
Abandoned _____

Map No. KANSAS Sec. 36 Twp. 31 R. 2^E


Well No. 1-C Bussard Farm
Washoma etal Company

220 Ft. from N. Line

..... Ft. from S. Line

..... Ft. from E. Line

207 Ft. from W. Line

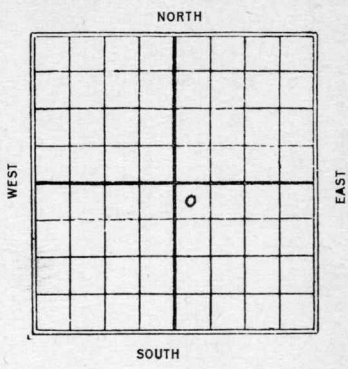

1929

Date

REPORT

Date	REPORT
10/9	Location
10/16	
10/23	
10/30	Spdg.
11/6	set 15" - 490'
11/13	Wrlg 810'
11/20	" 1505'
11/27	" 1842'
12/4	sand 1897'
	Oil 1933-37
	swab 50 bbl 13 hrs.
12/11	sand 1897-1937
	T.D. 1937'
	112 bbls oil
	Comp.

Summer

KANSAS

Map No. _____ Sec. 36 Twp. 31 R. 2^E

Well No. 1 "C" Bussard.

Washoma et al Company

Contractor _____

FIRST REPORTS

SECTION PLAT

220 Ft. from N. Line
 _____ Ft. from S. Line
 _____ Ft. from E. Line
207 Ft. from W. Line

		0	

Location ✓
 Rig up _____
 Drilling and Remarks: _____

RECORD

Cased _____ in., _____ ft.
 Sand _____
 Gas _____
 Oil _____
 Total Depth _____

PRODUCTION

1st 24 hrs. Nat. _____
 1st 24 hrs. after shot _____
 Gas _____ Cu. Ft.
 Dry Hole _____
 Abandoned _____

Date 1929
OCT 9 19 _____

CHAS. L. SHERWOOD
 Scout

Summer

Map No. 1 **KANSAS** Sec. 36 Twp. 31 R. 2^E

Well No. 1 "C" Bussard

Washema et al Company

Contractor

COMPLETE

SECTION PLAT

280 Ft. from N. Line

..... Ft. from S. Line

..... Ft. from E. Line

207 Ft. from W. Line

		0	

Location.....

Rig up.....

Drilling and Remarks:

112 Bl.

RECORD

Cased..... in., ft.

Sand 1897-1937

Gas.....

Oil.....

Total Depth 1937

PRODUCTION

1st 24 hrs. Nat.....

1st 24 hrs. after shot.....

Gas..... Cu. Ft.

Dry Hole.....

Abandoned.....

Date

DEC 1 1 1929

CHAS. L. SHERWOOD

..... 192..... Scout