

Butler


Form 51-5M-3-26-22544

Map No. 17N Sec. 12 Twp. 27 R. 7

Well No. 5 Stewart (Seward) Farm

White Eagle Company

NORTH

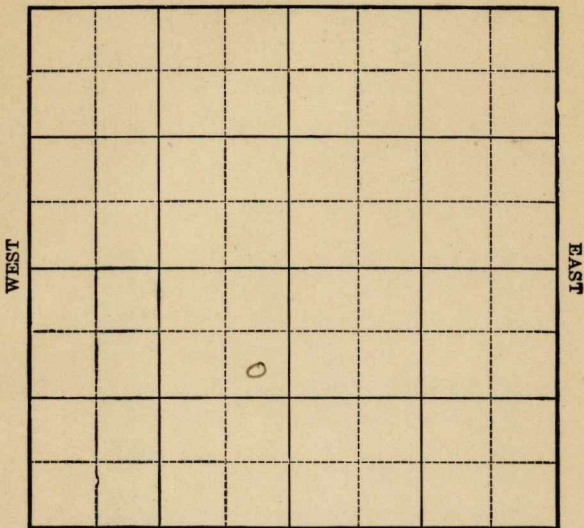

SOUTH

Location _____

Drilling Remarks

Rig Up _____

Drilling Remarks

RECORD

Cased _____ in. _____ ft.

Sand _____

Gas _____

Oil _____

Total Depth _____

PRODUCTION

1st 24 hrs. Nat. _____

1st 24 hrs. after shot _____

Gas _____ cu. ft.

Dry Hole _____


Abandoned _____

Map No. 11 am Sec. 12 Twp. 27 R. 7Well No. 5 Stewart Farm
White Eagle O.K. Company990 Ft. from N. Line

_____ Ft. from S. Line

330 Ft. from E. Line

_____ Ft. from W. Line

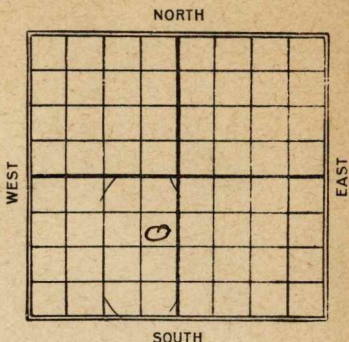1926

Date

REPORT

9/15	Location
9/22	Bldg rig
9/29	rigging up
10/3	Drill 728
10/27	6" 2230'
11/11	Sand 2620-32, I.D. 2641 U.P. 5"
11/23	Sand 2679-2721 50 gts./small sho D. & A. 2768

Butler

10 KANSAS 12 Twp. 27 R. 7

Well No. 5 Stewart

White bag O.R. O.H.

Company

Contractor

FIRST REPORTS

SECTION PLAT

990


Ft. from N. Line

Ft. from S. Line

330

Ft. from E. Line

Ft. from W. Line

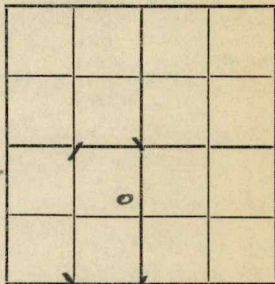

Location

Rig up

Drilling and Remarks:

RECORD

Cased _____ in., _____ ft.

Sand _____

Gas _____

Oil _____

Total Depth _____

PRODUCTION

1st 24 hrs. Nat. _____

1st 24 hrs. after shot _____

Gas _____ Cu. Ft.

Dry Hole _____

Abandoned _____

Date

SEP 15 1926 CHAS. L. SHERWOOD

192

Scout

10 KANSAS

Butler

Map No. _____ Sec. 12 Twp. 27 R. 7

Well No. 5 Howard

White Eagle O&G _____ Company

_____ Contractor

COMPLETED

SECTION PLAT

990

Ft. from N. Line


Ft. from S. Line

230

Ft. from E. Line

Ft. from W. Line

ABANDONED

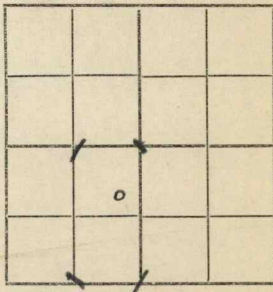

Location _____

Rig up _____

Drilling and Remarks:

say smae showed

DLK

2768

RECORD

Cased _____ in., _____ ft.

Sand 2679-2721

Gas _____

Oil _____

Total Depth 2768

PRODUCTION

1st 24 hrs. Nat. _____

1st 24 hrs. after shot _____

Gas _____ Cu. Ft.

Dry Hole ✓

Abandoned ✓

Date

NOV 23 1926

CHAS. L. SHERWOOD

192

Scout