


Summer

Map No. _____ Sec. *36* Twp. *31* R. *2E*

Well No. *6 - River Bed* Farm _____

Rolana Pet Corp. Company _____

NORTH

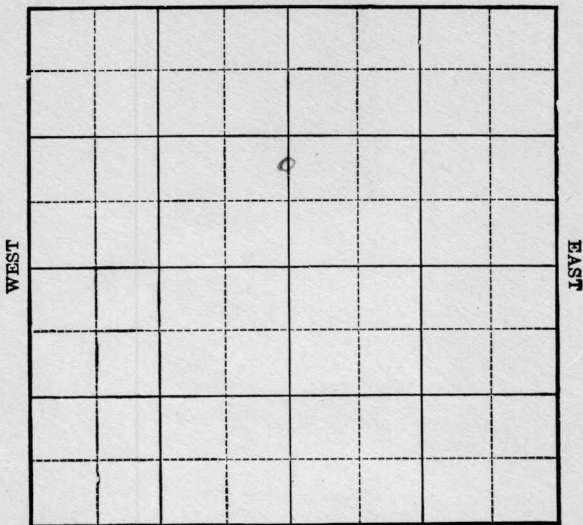

SOUTH

Location _____

Drilling Remarks _____

Rig Up _____

Drilling Remarks _____

RECORD

Cased _____ in. _____ ft.

Sand _____

Gas _____

Oil _____

Total Depth _____

PRODUCTION

1st 24 hrs. Nat. _____

1st 24 hrs. after shot _____

Gas _____ cu. ft.

Dry Hole _____

Abandoned _____

summer

Map No. Sec. 36 Twp. 31 R. 2 E


Well No. 6 - River Bed Farm
Potana Pet Corp Company

1331 Ft. from N. Line

_____ Ft. from S. Line

2641 Ft. from E. Line

_____ Ft. from W. Line

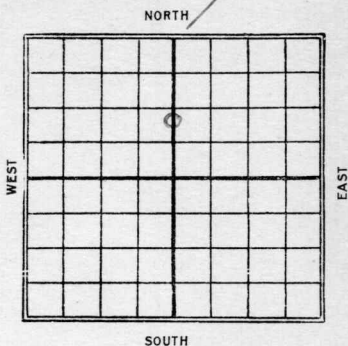

1927

Date

REPORT

3/2 Location

3/9 Driving piles

3/16 _____

3/23 _____

3/30 Rig

4/6 _____

4/13 Rigging up

4/20 Spud 290

4/27 Drlg 564

5/4 " 1335

5/11 T.D. 1610 - u. R. 8"

5/18 top sand 1850 - oil 1885 - T.D. 1910 -

Shot 40 qts. 1885 - 1910 - No test

5/25 \$ 1850

oil 1885

T.D. 1910 40 qts 650 bbls

Map No. KANSAS Sec. 36 Twp. 31 R. 2E

Well No. 6. River Bed.

Roxana Pet. Corp. Company

Contractor

SECTION PLAT

		o	

1331 Ft. from N. Line

----- Ft. from S. Line

2641 Ft. from E. Line

----- Ft. from W. Line

FIRST REPORTS

Location ✓-----

Rig up -----

Drilling and Remarks:

RECORD

Cased ----- in., ----- ft.

Sand -----

Gas -----

Oil -----

Total Depth -----

PRODUCTION

1st 24 hrs. Nat. -----

1st 24 hrs. after shot -----

Gas ----- Cu. Ft.

Dry Hole -----

Abandoned -----

Date

MAR 2 1927

S. J. LEWIS

Scout

Map No. KANSAS Sec. 36 Twp. 31 R. 2E

Well No. 6 River Bed

Roxana Pet Corp Company

Contractor

SECTION PLAT

133 1/2 Ft. from N. Line

_____ Ft. from S. Line

264 1/2 Ft. from E. Line

_____ Ft. from W. Line

	o		

COMPLETED

Location _____

Rig up _____

Drilling and Remarks:

T.S. 1850
Oil 1885
T.D. 1910
Spd 40g to
1885 to 1910
650 g/l.

RECORD

Cased _____ in., _____ ft.

Sand _____

Gas _____

Oil _____

Total Depth _____

PRODUCTION

1st 24 hrs. Nat. _____

1st 24 hrs. after shot _____

Gas _____ Cu. Ft.

Dry Hole _____

Abandoned _____

Date

MAY 25 1927

S. J. LEWIS

Scout