
Form 51—5-19—5M—Mid-West

Map No._____ Sec. 36 Twp. 31 S R. 2 E

Well No. 1 Sleigh Farm

Edmondale oil Company

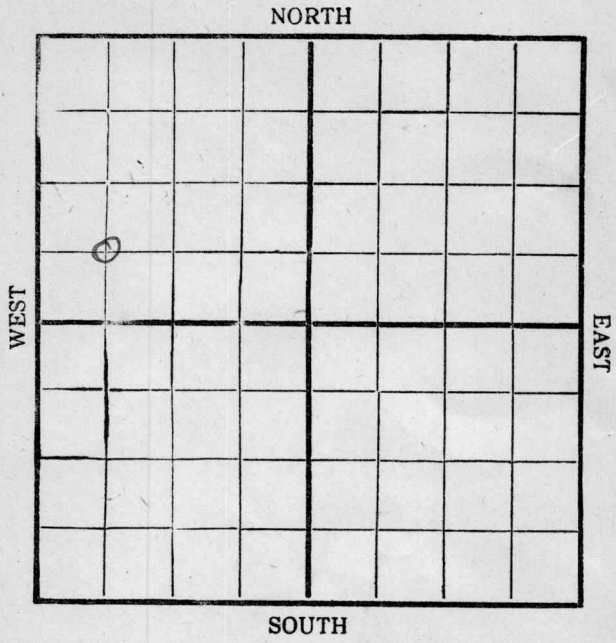

Location _____

Drilling Remarks:

Rig Up _____

Drilling Remarks:

RECORD

Cased _____ in. _____ ft.

Sand _____

Gas _____

Oil _____

Total Depth _____

PRODUCTION

1st 24 hrs. Nat. _____

1st 24 hrs. after shot _____

Gas _____ cu. ft.

Dry Hole _____

Abandoned _____

Form 26—1M—4-19—Mid-West


Map No._____ Sec. 36 Twp. 31 S R. 2 E

Well No. 1 Sleigh

Elmendale Oil Company

_____ Contractor

SECTION PLAT

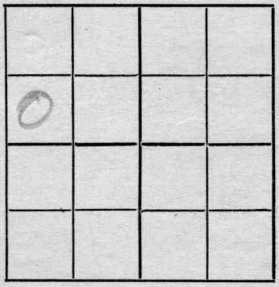

_____ Ft. from N. Line

_____ Ft. from S. Line

_____ Ft. from E. Line

_____ Ft. from W. Line

Cente. SW NW.

Location _____

Rig up _____

Drilling and Remarks:

Rely. 665-1

RECORD

Cased _____ in., _____ ft.

Sand _____

Gas _____

Oil _____

Total Depth _____

PRODUCTION

1st 24 hrs. Nat. _____

1st 24 hrs. after shot _____

Gas _____ Cu. Ft.

Dry Hole _____

Abandoned _____

Date

8/20 191 9

_____ Scout

FORM 26 250 BKS. 4-28 WESTERN

Hummer

K1 KANSAS

MAP NO. _____ SEC. 36 TWP. 31S R. 25E


WELL NO. 1 Sleigh

Keta Oil

COMPANY

CONTRACTOR

SECTION PLAT

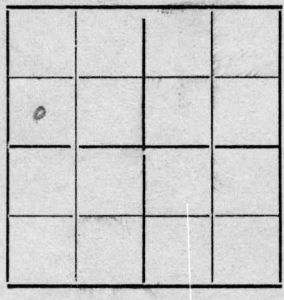

_____ FT. FROM N. LINE

_____ FT. FROM S. LINE

_____ FT. FROM E. LINE

_____ FT. FROM W. LINE

LOCATION _____

RIG UP _____

DRILLING AND REMARKS:

we shut
3565

RECORD

CASED _____ IN., _____ FT.

SAND _____

GAS _____

OIL _____

TOTAL DEPTH 3540

PRODUCTION

1ST 24 HRS. NAT. _____

1ST 24 HRS. AFTER SHOT _____

GAS _____ CU. FT.

DRY HOLE _____

ABANDONED _____

DATE

3/25 1920

_____ SCOUT