


Map No. _____ Sec. 12 Twp. 27 R. 7
 Well No. 2 - Warren Farm _____
Tidal oil co Company

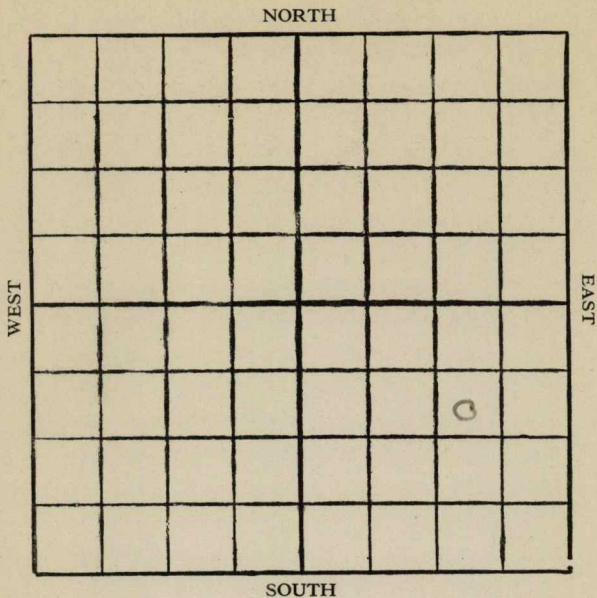

Location _____

Drilling Remarks _____

Rig Up _____

Drilling Remarks _____

RECORD

Cased _____ in. _____ ft.

Sand _____

Gas _____

Oil _____

Total Depth _____

PRODUCTION

1st 24 hrs. Nat. _____

1st 24 hrs. after shot _____

Gas _____ cu. ft.

Dry Hole _____

Abandoned _____

Kansas

Map No. _____ Sec. 12 Twp. 27 R. 7Well No. 2 - Warren FarmTidal Oil Company

NORTH

990 Ft. from N. Line

_____ Ft. from S. Line

990 Ft. from E. Line

_____ Ft. from W. Line

WEST

EAST

SOUTH

1977

Date

REPORT

2/16	Rig up
2/24	Rigging up
3/2	Drill 680
3/9	" 1400
3/16	" 2072
3/24	" 2700
3/30	top sand 2731-68 T.D. 2769 shot 60 qts., swabbing + C.O. - Est. 30 bbls.
4/7	_____
4/13	sand 2731-2768 60/15 bbls T.D. 2769

Butler

10 **KANSAS**

Map No. _____ Sec. 12 Twp. 27 R. 7

Well No. 2 Warren

Tidal oil Co Company


Contractor _____

FIRST REPORTS**SECTION PLAT**990 Ft. from N. Line

_____ Ft. from S. Line

990 Ft. from E. Line

_____ Ft. from W. Line

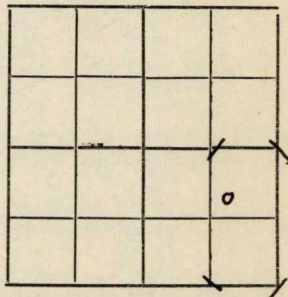

Location _____

Rig up ☒

Drilling and Remarks:

RECORD

Cased _____ in., _____ ft.

Sand _____

Gas _____

Oil _____

Total Depth _____

PRODUCTION

1st 24 hrs. Nat. _____

1st 24 hrs. after shot _____

Gas _____ Cu. Ft.

Dry Hole _____

Abandoned _____

Date

FEB 16 1927**CHAS. L. SHERWOOD**

192

Scout

10 **KANSAS** Sec. 12 Twp. 27 R. 7

Well No. 2 Warren
Fidal oil Co Company

Contractor

COMPLETED

SECTION PLAT

990 Ft. from N. Line

Ft. from S. Line

990 Ft. from E. Line

Ft. from W. Line

			0

Location

Rig up

Drilling and Remarks:

60 15 Bls.

RECORD

Cased in. ft.

Sand 2731-2768

Gas

Oil

Total Depth 2769'

PRODUCTION

1st 24 hrs. Nat.

1st 24 hrs. after shot

Gas Cu. Ft.

Dry Hole

Abandoned

Date

APR 13 1957

CHAS. L. SHERWOOD

192

Scout