
Form 51—5M—3-26—22544

KANSAS

Map No. _____ Sec. 36 Twp. 31 R. 2E

Well No. 9— River Bed Farm

Roeana Pet Corp Company

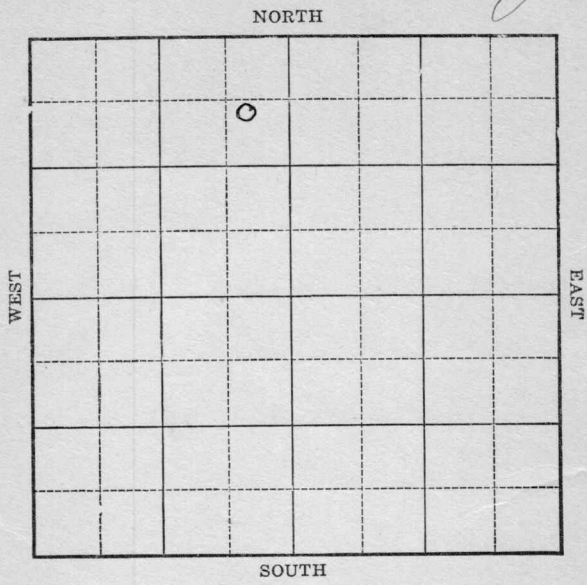


Location _____

Drilling Remarks

Rig Up _____

Drilling Remarks

RECORD

Cased _____ in. _____ ft.

Sand _____

Gas _____

Oil _____

Total Depth _____

PRODUCTION

1st 24 hrs. Nat. _____

1st 24 hrs. after shot _____

Gas _____ cu. ft.

Dry Hole _____

Abandoned _____

Form 252A—5M—4-27—27425

Map No. KANSAS Sec. 36 Twp. 31 R. 2E

Well No. 9 – River Bed Farm


Roxana Pet Corp Company

731 Ft. from N. Line

..... Ft. from S. Line

534 Ft. from E. Line

..... Ft. from W. Line

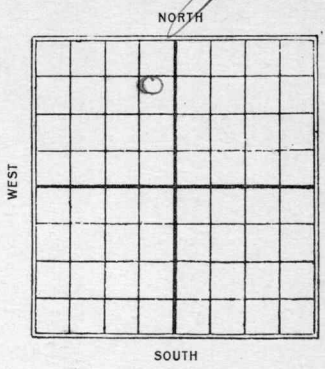


1927

| Date | REPORT |
|---|---|
| 12/28 | Piles |
| 1/4/28 | " |
| 1/11 | " |
| 1/18 | Bldg rig |
| 1/25 | Rigging up – |
| 1/31 | Drlg – 370 |
| 2/15 | Top Sand 1877 – drlg. |
| 2/22 | Top sand 1877 |
| | T.D. 1904 |
| | 40/1884–1904 |
| | swabbed 525 bbls |
| | 24 hrs |

Form 26-1M Blks. 3-23-11959.





Contractor

SECTION PLAT

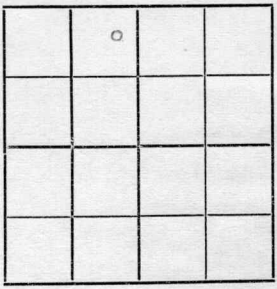

731 Ft. from N. Line

Ft. from S. Line

534 Ft. from E. Line

Ft. from W. Line

FIRST REPORTS

Location

Rig up

Drilling and Remarks:

Piled

RECORD

Cased in., ft.

Sand

Gas

Oil

Total Depth

PRODUCTION

1st 24 hrs. Nat.

1st 24 hrs. after shot

Gas Cu. Ft.

Dry Hole

Abandoned

Date

DEC 28 1927 192

S. J. LEWIS Scout

Form 26—1M Bks. 3-23—11959.


Map No. 1 KANSAS Sec. 26 Twp. 31 R. 2E

Well No. 9 River Bed

Roxana Pet. Corp. Company

Contractor

SECTION PLAT

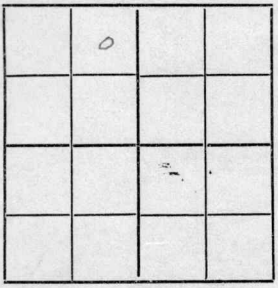

731 Ft. from N. Line

Ft. from S. Line

534 Ft. from E. Line

Ft. from W. Line

COMPLETED

Location

Rig up

Drilling and Remarks:

T.D. 1877
T.D. 1904
40/1884-1904
24 hrs.

RECORD

Cased in., ft.

Sand

Gas

Oil

Total Depth

PRODUCTION

1st 24 hrs. Nat.

1st 24 hrs. after shot

Gas Cu. Ft.

Dry Hole

Abandoned

Date

FEB 22 1928

192

S. J. LEWIS Scout