


Summer

Map No. _____ Sec. *36* Twp. *31* R. *2E*

Well No. *3 - Sleigh* Farm _____
Rovana Pet Corp. Company

NORTH

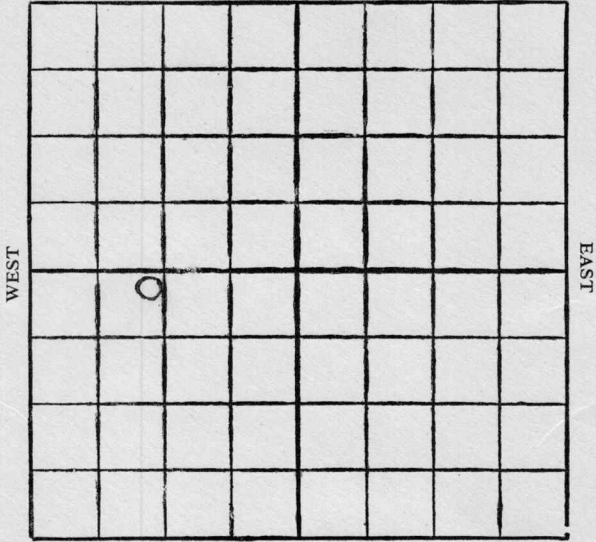

SOUTH

Location

Rig Up.....

Drilling Remarks

Drilling Remarks

.....

.....

RECORD

PRODUCTION

Cased in. ft.

1st 24 hrs. Nat.

Sand

1st 24 hrs. after shot.....

Gas

Gas cu. ft.

Oil

Dry Hole.....

Total Depth.....

Abandoned.....

Summer

Map No. _____ Sec. *36* Twp. *31* R. *2E*

Well No. *3-Sleigh* Farm _____

Rotana Pet Corp Company _____


NORTH

_____ Ft. from N. Line

2327 Ft. from S. Line

_____ Ft. from E. Line

1212 Ft. from W. Line

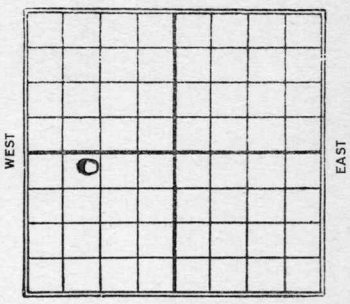

1927

Date

REPORT

<i>6/15</i>	<i>Location</i>
<i>6/22</i>	<i>Rig bldg.</i>
<i>6/29</i>	<i>Rig</i>
<i>7/6</i>	<i>Drly 570</i>
<i>7/13</i>	<i>" 1240</i>
<i>7/20</i>	<i>" 1645</i>
<i>7/27</i>	<i>\$ 1864 T.D. 1917</i>
	<i>Shot 60 gts 1894-1917</i>
	<i>230 bbls oil & 145</i>
	<i>bbls water 18 hrs</i>

KANSAS

Map No. _____ Sec. 36 Twp. 31 R. 2E

Well No. 3 Sleigh

Roxana P. & O. Corp. Company

_____ Contractor

SECTION PLAT

0			

_____ Ft. from N. Line

2324 Ft. from S. Line

_____ Ft. from E. Line

1212 Ft. from W. Line

COMPLETED

Location _____

Rig up _____

Drilling and Remarks:

TS 1864
TD 1917
Shot 609 ts
1894 & 1917
2308 & 6 oil &
145 & 6 water 18/10

RECORD

Cased _____ in., _____ ft.
 Sand _____
 Gas _____
 Oil _____
 Total Depth _____

PRODUCTION

1st 24 hrs. Nat. _____
 1st 24 hrs. after shot _____
 Gas _____ Cu. Ft.
 Dry Hole _____
 Abandoned _____

Date

JUL 27 1927
192

S. J. LEWIS

Scout