
Form 51—5M—4-27—27423

Map No. KANSAS Sec. 36 Twp. 31 R. 2E

Well No. #1 Wenrich Farm

~~Kansas Pet. Corp~~ Company

Washonga

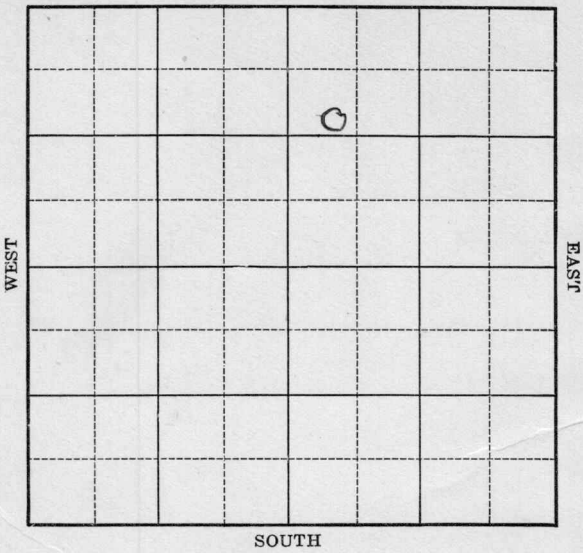

Location

Drilling Remarks

Rig Up

Drilling Remarks

RECORD

Cased ____ in. ____ ft.

Sand

Gas

Oil

Total Depth

PRODUCTION

1st 24 hrs. Nat.

1st 24 hrs. after shot

Gas ____ cu. ft.

Dry Hole

Abandoned

Form 252A—5M—4-27—27425

Summer

Map No. KANSAS Sec. 36 Twp. 31 R. 25E

Well No. #1 Wenrick Farm

~~Roxana Pet Corp~~ Company


Trashoma

1050 Ft. from N. Line

Ft. from S. Line

Ft. from E. Line

430 Ft. from W. Line

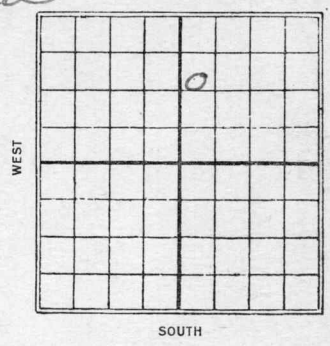

1927

Date	REPORT
10/19	—
10/26	Location
11/2	—
11/9	—
11/16	—
11/23	—
11/29	—
12/7	—
12/14	—
12/21	Rigging up
12/28	Spud
1928	
1/4	Drlg 395'
1/11	T.D. 550 - fishing tools.
1/18	—
1/25	Drlg 890-
1/31	" 1090
2/15	Top Sand 1880 - no oil - H.T.W. @ 1950 - 54 - Shut down
2/22	D. & A. 1954

Form 26—1M Bks. 3-23—11959.

Gamier


Map No. KANSAS Sec. 26 Twp. 31 R. 2E

Well No. 4 Henrich

Roxana Pet. Corp. Company

Contractor

SECTION PLAT

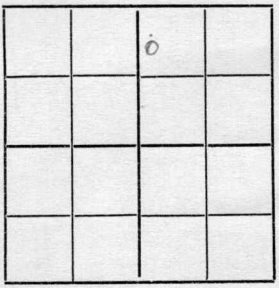

1050 Ft. from N. Line

Ft. from S. Line

Ft. from E. Line

430 Ft. from W. Line

FIRST REPORTS

Location

Rig up

Drilling and Remarks:

RECORD

Cased in., ft.

Sand

Gas

Oil

Total Depth

PRODUCTION

1st 24 hrs. Nat.

1st 24 hrs. after shot

Gas Cu. Ft.

Dry Hole

Abandoned

Date

OCT 19 1927

192

S. J. LEWIS

Scout

Form 26 1M Blks. 3-23 11959.


Map No. 1 KANSAS Sec. 36 Twp. 31 R. 25E

Well No. 1 Henrich

Washington Company

Contractor

SECTION PLAT

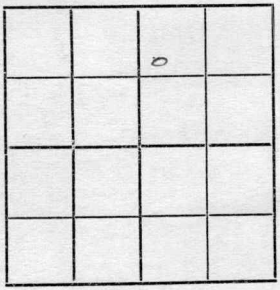

1030 Ft. from N. Line

Ft. from S. Line

Ft. from E. Line

1430 Ft. from W. Line

Correction.

Location

Rig up

Drilling and Remarks:

Rigging up

Reported this as

No 4 Henrich

Rogana Pet. Corp.

They have farmed

this to Washington

RECORD

Cased in., ft.

Sand

Gas

Oil

Total Depth

PRODUCTION

1st 24 hrs. Nat.

1st 24 hrs. after shot

Gas Cu. Ft.

Dry Hole

Abandoned

Date

DEC 21 1927 192

S. J. LEWIS Scout

Form 26—1M Bks. 3-23—11959.

Revised


Map No. KANSAS Sec. 26 Twp. 31 R. 2E

Well No. 1 Dennis

Oklahoma Company

Contractor

SECTION PLAT

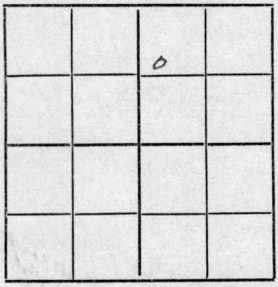

1252 Ft. from N. Line

Ft. from S. Line

Ft. from E. Line

436 Ft. from W. Line

ABANDONED

Location

Rig up

Drilling and Remarks:

7 III 1954

D & A

RECORD

Cased in., ft.

Sand

Gas

Oil

Total Depth

PRODUCTION

1st 24 hrs. Nat.

1st 24 hrs. after shot

Gas Cu. Ft.

Dry Hole

Abandoned

Date

FEB 2 2 1928 192

S. J. LEWIS Scout

FORM 26 250 BKS. 4-28 WESTERN

Summer

KANSAS


MAP NO. KANSAS SEC. 36 TWP. 31S R. 7E

WELL NO. 1 Wellnich

Haskon COMPANY

CONTRACTOR

SECTION PLAT

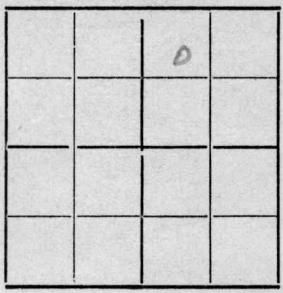

_____ FT. FROM N. LINE

_____ FT. FROM S. LINE

_____ FT. FROM E. LINE

_____ FT. FROM W. LINE

oil

LOCATION _____

RIG UP _____

DRILLING AND REMARKS:

1880 ft

1950-1954

182 ft.

RECORD

CASED _____ IN., _____ FT.

SAND _____

GAS _____

OIL _____

TOTAL DEPTH 1950

PRODUCTION

1ST 24 HRS. NAT. _____

1ST 24 HRS. AFTER SHOT _____

GAS _____ CU. FT.

DRY HOLE ✓

ABANDONED ✓

DATE 2/22/28

_____ SCOUT