

Butler


KANSAS

SECTION 12 TOWNSHIP 27 RANGE 7 E

WELL NO. #3 Worrell

COMPANY White & Ellis et al

NORTH

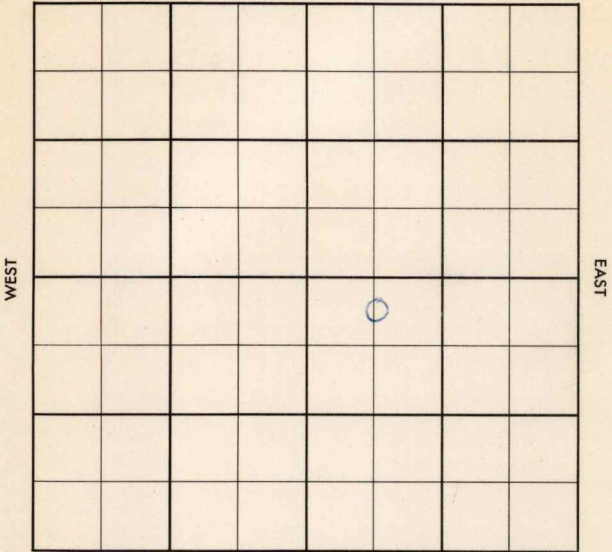

SOUTH

Butler

KANSAS

SEC.

TWP.

R.

12

27

7E

WELL NO.

#3 Worrel

FARM

COMPANY

White & Ellis etal

CONTRACTOR

Co. Tools

Seward

100


Ft. from N. Line

Ft. from S. Line

1935

Ft. from E. Line

Ft. from W. Line

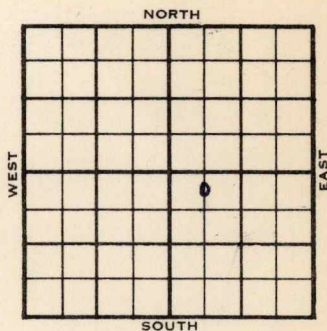C N $\frac{1}{2}$ NW SE

1955

ELEVATION

1517

REPORT

12-21

RUR

1956

1-25

Comm. 12-20-55
8 5/8" @ 105/25
5 1/2" @ 269 1/4/50
DD 2723, frac
Comp. 25 bopd
L. 1752
KC 2057
Cattleman 2640
Bart 2684
TD 2700'

COMPLETED

County

~~Butler~~

Elev.

Sec.

12

Twp.

27

Rge.

7E

Company

White & Ellis et al.

Farm Name

Worrel

No.

3

TOPS

DEPTH

LOG

DATUM

Loc. in Sec.

Anh.

T.P.

H.

Tr.

Dg.

B.L.

L.

K.C.

B.K.C.

Ce.

C.

M.

M.

K.

Mz.

Me.

V.

S.

S.

A.

R.

P.E.

G.

T.D.

C N $\frac{1}{2}$ NW SE

100' NL

1935' EL

Geol.

Contr.

Co. tools

Pool

Seward

FIRST REPORT

DEC 21 '35

Date Comm.

RUR

Co.

Lse.

No.

Sec.

T.

R.

County Butler Elev. 1517 Co.
 Sec. 12 Twp. 27 Rge. 7E
 Company White & Ellis et al.
 Farm Name Worrel No. 3

TOPS	DEPTH	LOG	DATUM	Loc. in Sec.
Anh.				C N $\frac{1}{2}$ NW SE
Tr.				100' NL
H.				1935' EL
Tr.				
Dg.				
Bl.				
L.	1752		235	Geol.
K.C.	2057		340	Contr.
B.K.C. <i>Cattlemans</i>	2640		1123	Co. tools
Ce. <i>Bart</i>	2684		1167	Pool
C.				Seward
M.				
M.				
K.				
Mz.				
Me.				
V.				
S.				
S.				
A.				
R.				
Pe.				
G.				
T.D.	2700			

Date Comm. 12-20-55 JAN 25 1956
8 5/8" @ 105/25 5 1/2" @ 2694/50 DD 2723
frac Comp. 25 bopd

COMPLETE