

KANSAS


FORM 51 5M 6-46 PETROL

Summer County

Section 36 Township 31 Range 2E

Well No. #4 Wenrick

Company Shell

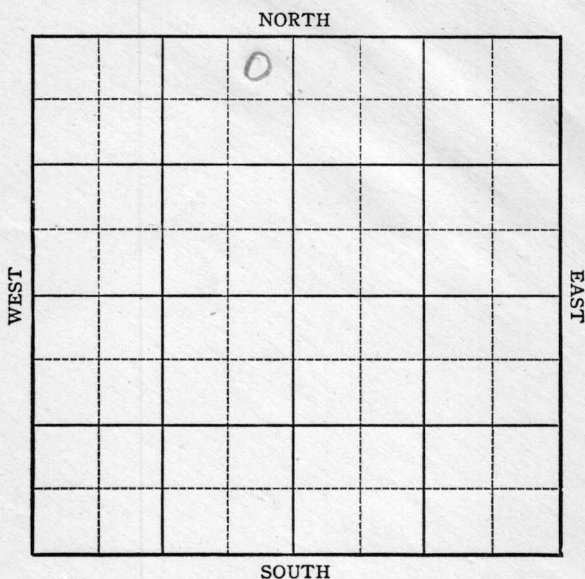

KANSAS

Sumner County ✓


Sec. 36 Twp. 31 R. 2EWell No. #4 Wenrick Farm

Shell

Oxford Company

403 Ft. from N. Line Ft. from S. Line215 Ft. from E. Line Ft. from W. Line

NE NW

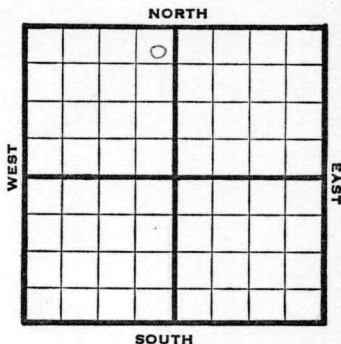

1946

Elev. 1160

REPORT

7/17

8" @ 154

Drlg. 1591'

7/23

Arb 2644-47 TD

7/30

4" @ 2644

500 acid swb 384 oil plus 48 W
in 18 hrs.

8/7

Arb. 2644

4" @ 2644

500 acid.

TD 2647'

Pump 135 oil plus 315 W. Pot.

Grav. 36.0

COMPLETED


Kansas Pool Name OxfordMap No. 36 Sec. 31 Twp. 2EWell No. 4 WenrichShell Company

FIRST REPORT

Contractor

NE NW

SECTION PLAT

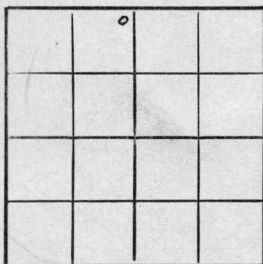493 Ft. from N. Line

Ft. from S. Line

215 Ft. from E. Line

Ft. from W. Line

Sumner County

Location

Rig up

Drilling and Remarks:

8" @ 154'

1591'

RECORD

Cased _____ in., _____ ft.

Sand _____

Gas _____

Oil _____

Total Depth _____

PRODUCTION

1st 24 hrs. Nat. _____

1st 24 hrs. after shot _____

Gas _____ Cu. Ft.

Dry Hole _____

Abandoned _____

Date

JUL 17 1946 19S. J. LEWIS Scout

KANSAS

Kansas

Pool Name Oxford PoolMap No. 1 Sec. 36 Twp. 31 R. 2EWell No. 4 Wenrick

Shell

Company

COMPLETED

Contractor

NE NW

E 1/160
SECTION PLAT

	6		

493 Ft. from N. Line

Ft. from S. Line

215 Ft. from E. Line

Ft. from W. Line

Sumner County

Location

Rig up

Drilling and Remarks:

Cr 26444" 2644500 acidPump 135 oil +3.5 W Bt36 2/4

RECORD

Cased in., ft.Sand Gas Oil Total Depth 2647

PRODUCTION

1st 24 hrs. Nat. 1st 24 hrs. after shot Gas Cu. Ft.Dry Hole Abandoned

Date

AUG 7 1946 19

S. J. LEWIS

Scout