


Map No. KANSAS Sec. 36 Twp. 31 R. 2E

Well No. 6-Tator Farm _____
Rolana Pet Company

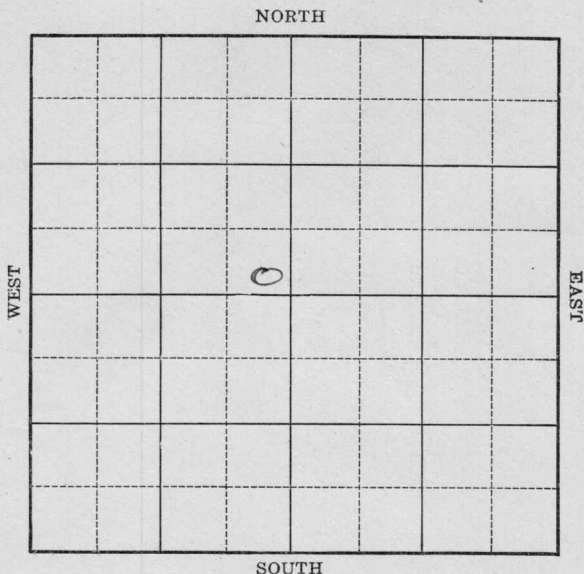

Location _____

Drilling Remarks _____

RECORD

Cased _____ in. _____ ft.

Sand _____

Gas _____

Oil _____

Total Depth _____

Rig Up _____

Drilling Remarks _____

PRODUCTION

1st 24 hrs. Nat. _____

1st 24 hrs. after shot _____


Gas _____ cu. ft.

Dry Hole _____

Abandoned _____

Map No. KANSAS Sec. 36 Twp. 31 R. 2E
 Well No. 6-Taton Farm
Roxana Pet Company

..... Ft. from N. Line
220 Ft. from S. Line
220 Ft. from E. Line
 Ft. from W. Line

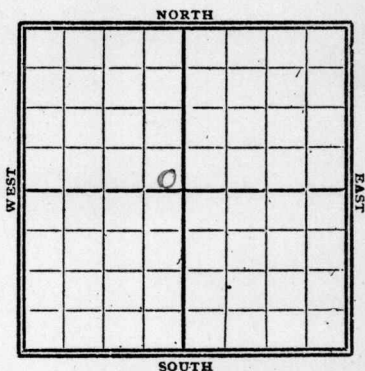

1928

Date	REPORT
7/18	Loc
7/25	—
8/1	—
8/7	—
8/15	—
8/22	—
9/5	—
9/12	—
9/19	—
9/26	—
10/3	—
10/10	Bldg Rig
10/17	Spud
10/24	Drlg 655'
10/31	" 810'
11/7	" 1820'
11/14	TS. 1937 TD 1989' 750 ft oil in hole
11/21	Top sand 1937' T.D. 1991'
	shot 20 qt - 90 bbls oil 12 bbls water Sump

Summer
K1
 Map No. KANSAS Sec. 36 Twp. 31 R. 2E

Well No. 6 Taton

Roxana Prod Corp Company

Contractor

SECTION PLAT

	0		

-----Ft. from N. Line

220 Ft. from S. Line

220 Ft. from E. Line

-----Ft. from W. Line

FIRST REPORTS

Location ✓

Rig up -----

Drilling and Remarks:

RECORD

Cased ----- in., ----- ft.

Sand -----

Gas -----

Oil -----

Total Depth -----

PRODUCTION

1st 24 hrs. Nat. -----

1st 24 hrs. after shot -----

Gas ----- Cu. Ft.

Dry Hole -----

Abandoned -----

Date

JUL 18 1928

192

S. J. LEWIS

Scout

Summer
KI
MAP NO. **KANSAS** SEC. *36* TWP. *31* R. *2E*

WELL No. *6 Taton*

Roxana Pet. Corp. COMPANY

CONTRACTOR

SECTION PLAT

		0	

_____ FT. FROM N. LINE

220 FT. FROM S. LINE

220 FT. FROM E. LINE

_____ FT. FROM W. LINE

COMPLETED

RECORD

LOCATION _____

RIG UP _____

DRILLING AND REMARKS:

Top Sand 1937
Total Depth 1991
20 ft sand
90 x 8 1/2 oil
12 x 8 1/2 water

CASED _____ IN., _____ FT.

SAND _____

GAS _____

OIL _____

TOTAL DEPTH *1991*

PRODUCTION

1ST 24 HRS. NAT. _____

1ST 24 HRS. AFTER SHOT _____

GAS _____ CU. FT.

DRY HOLE _____

ABANDONED _____

DATE

NOV 21 1928 192

S. J. LEWIS SCOUT