


Section 10 Township 31 Range 3E

Well No. #1 Mowder

Company K.T. Weidemann

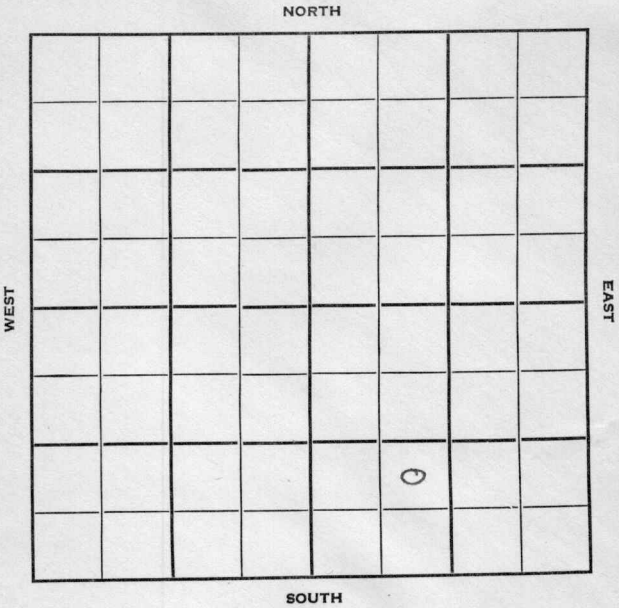

Sec. 10 Twp. 31 R. 3 E

Well No. # 1 Mowder Farm

K. T. Weidemann Company

Contractor


Ft. from N. Line

990 Ft. from S. Line

Ft. from E. Line

990 Ft. from W. Line

NE SW SE

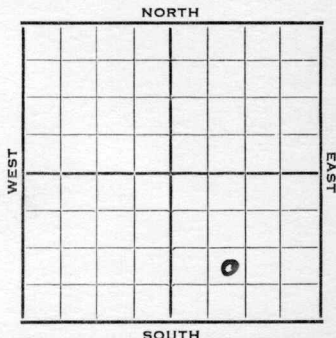

1952

Elev. 1253' REPORT

11/5

8" @ 138 WOR

1953
4/8

Oil Well

TD 3070

8" @ 138

KC 2515, B KC 2775, Marm. 2835, Cherokee 2959, Bart 3050

TD 3051

5" @ 3050

DD 3068, PB 3060, DD 3070

PB 3059, sd-frac

Comp. 5 bopd

COMPLETED

